


T. 5 S. R. 3 & 4 W. W. M.

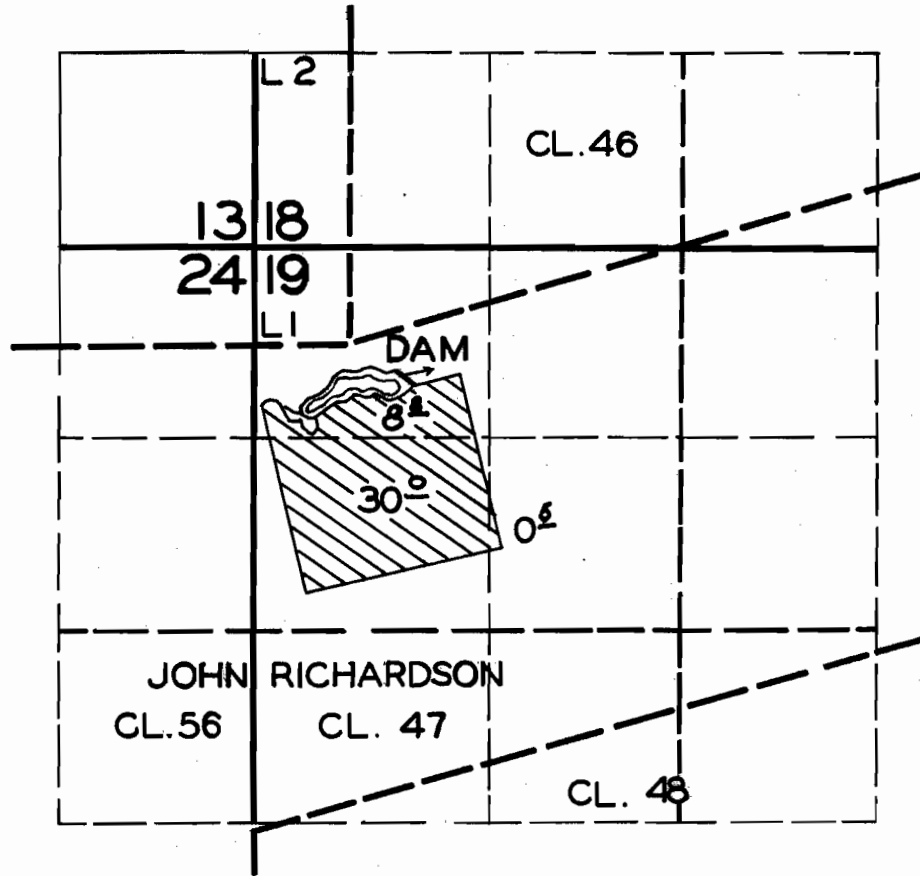

**FINAL PROOF SURVEY**

UNDER

R-21038

R-823

Application No. 21037... Permit No. 16484..

IN NAME OF

**CARL WOOD**

Surveyed 20MAY 1955, by ...T. JONES..