


T. 5 S. R. 3 & 4 W.W.M.

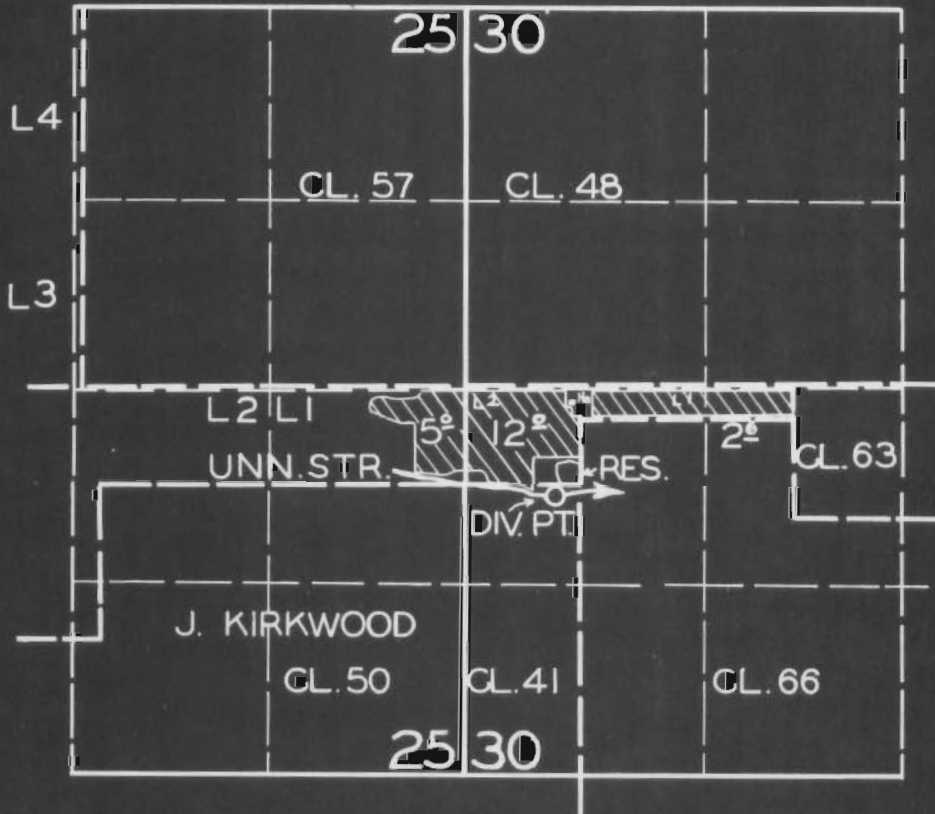

FINAL PROOF SURVEY

UNDER

R-24483

R-1123

Application No. 24484 Permit No. 20188

IN NAME OF

GUST JANZEN

Surveyed 23 MAY 1955, by T. JONES