


14100

21977

T.37S. R.23E. W.M

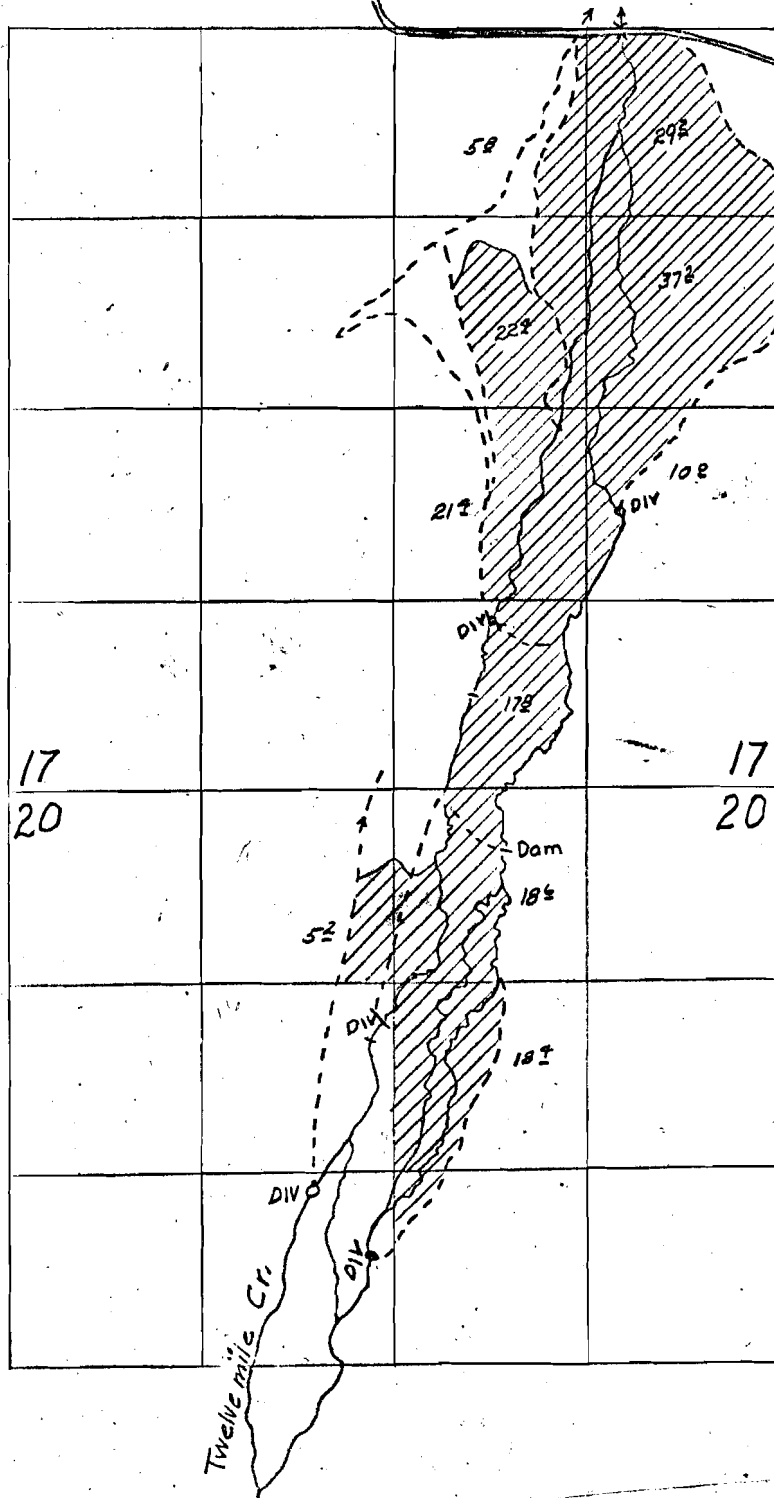

FINAL PROOF SURVEY

UNDER

Application No. 17206 Permit No. 14100

IN NAME OF

J. P. Egan

Surveyed June 15 1955, by T. Jones

57-23 ✓