


T. 8 S. R. 10 W. W.M.

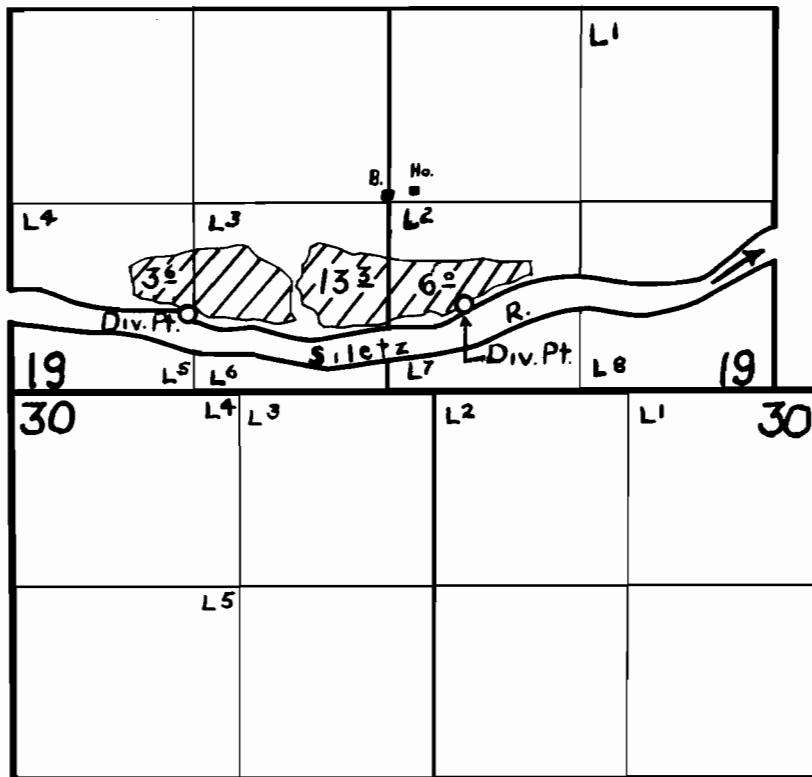

FINAL PROOF SURVEY

UNDER

Application No. 18800 Permit No. 14441

IN NAME OF

G. de BRETTERVILLE

Surveyed 26 Apr. 1955, by H. Coffman