


T. 4 S. R. 3 W. W.M.

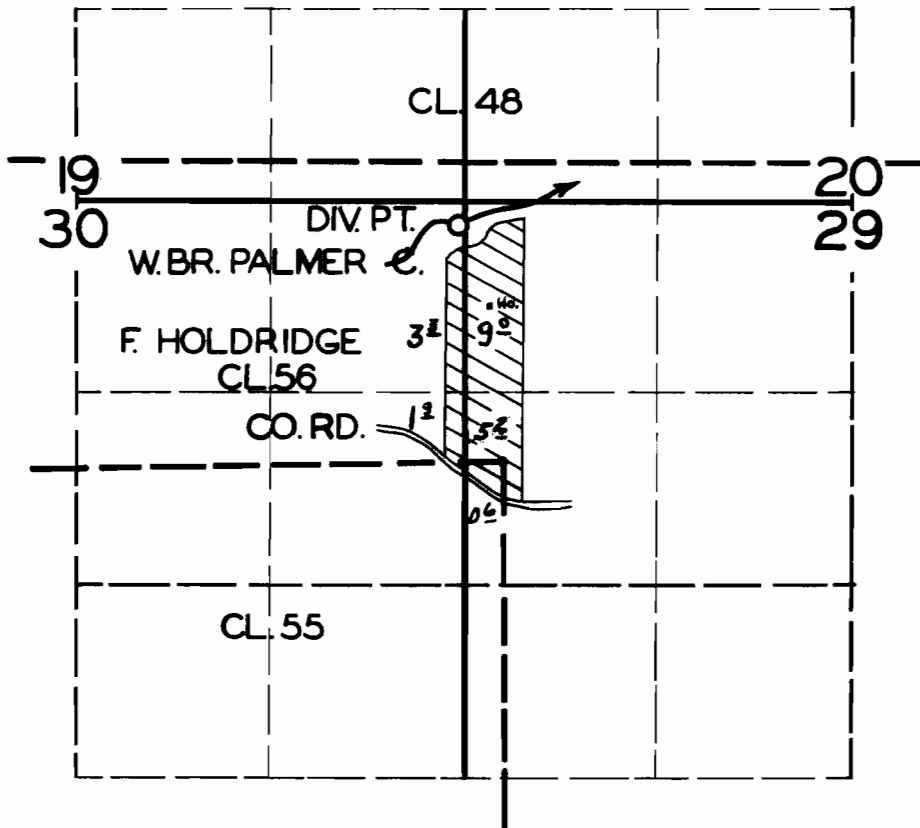

FINAL PROOF SURVEY
UNDER

Application No. ~~20395~~ Permit No. ~~15904~~
IN NAME OF

CLYDE H. MCKINNEY

Surveyed ~~8 JUNE~~ 1955, by ~~T. JONES~~