


T. 40S R. 20 E. W. M.

Final Proof Survey
Under

Application No. 20685 Permit No. 16181
In Name Of

James S. Snider & C. F. Snider

Inspected June 17, 1955 by T. Jones

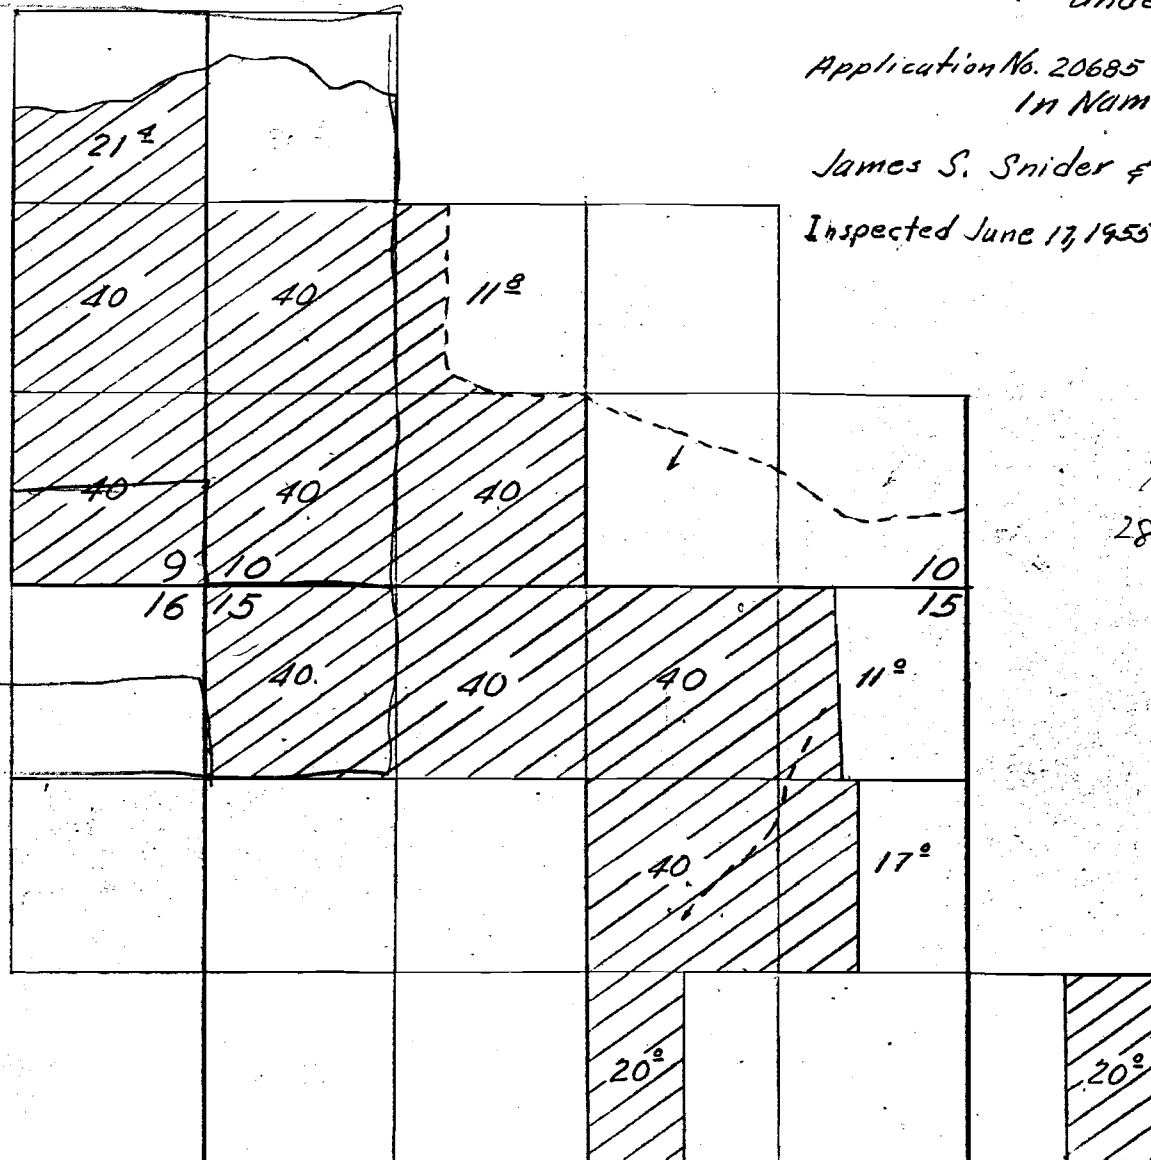

439.4
52.2
491.6

439.4
175.5
263.9
52.2
311.6
461.2
777.3

40-20 ✓

27 1/2
11.8
28

21981

16181

CHZ-38K-146

CB