


16182
21982

T. 40 S. R. 20 E. W. M.

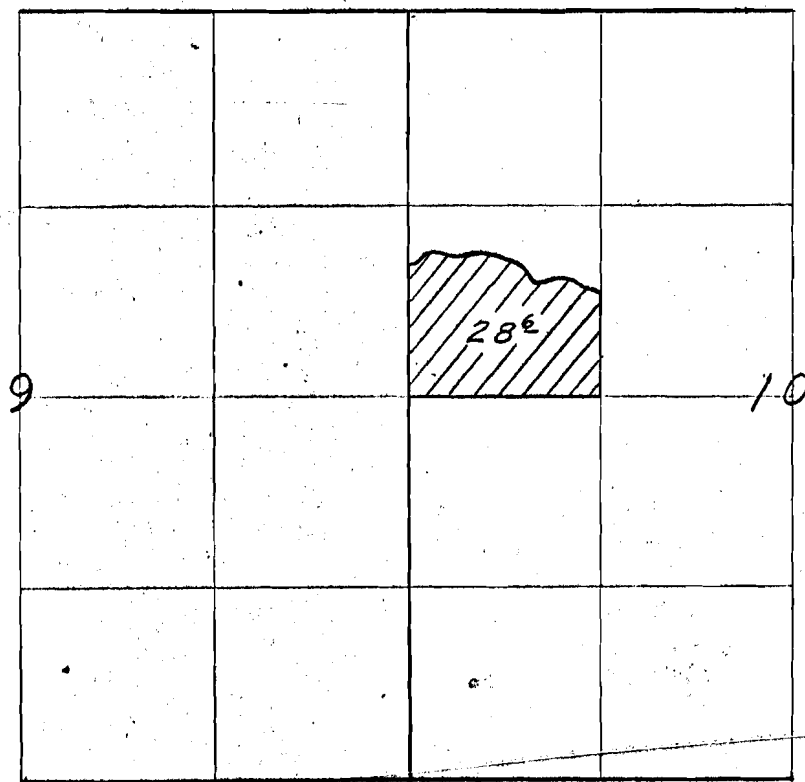

Final Proof Survey
Under

Application No. 20686 Permit No. 16182
In Name Of

James S. Snider & C. F. Snider

Inspected June 17, 1955 by T. Jones

40-20V

CH2-38K-146

EB