


SECTION
35

TOWNSHIP 24 & 25, RANGE 13, W. M.

North

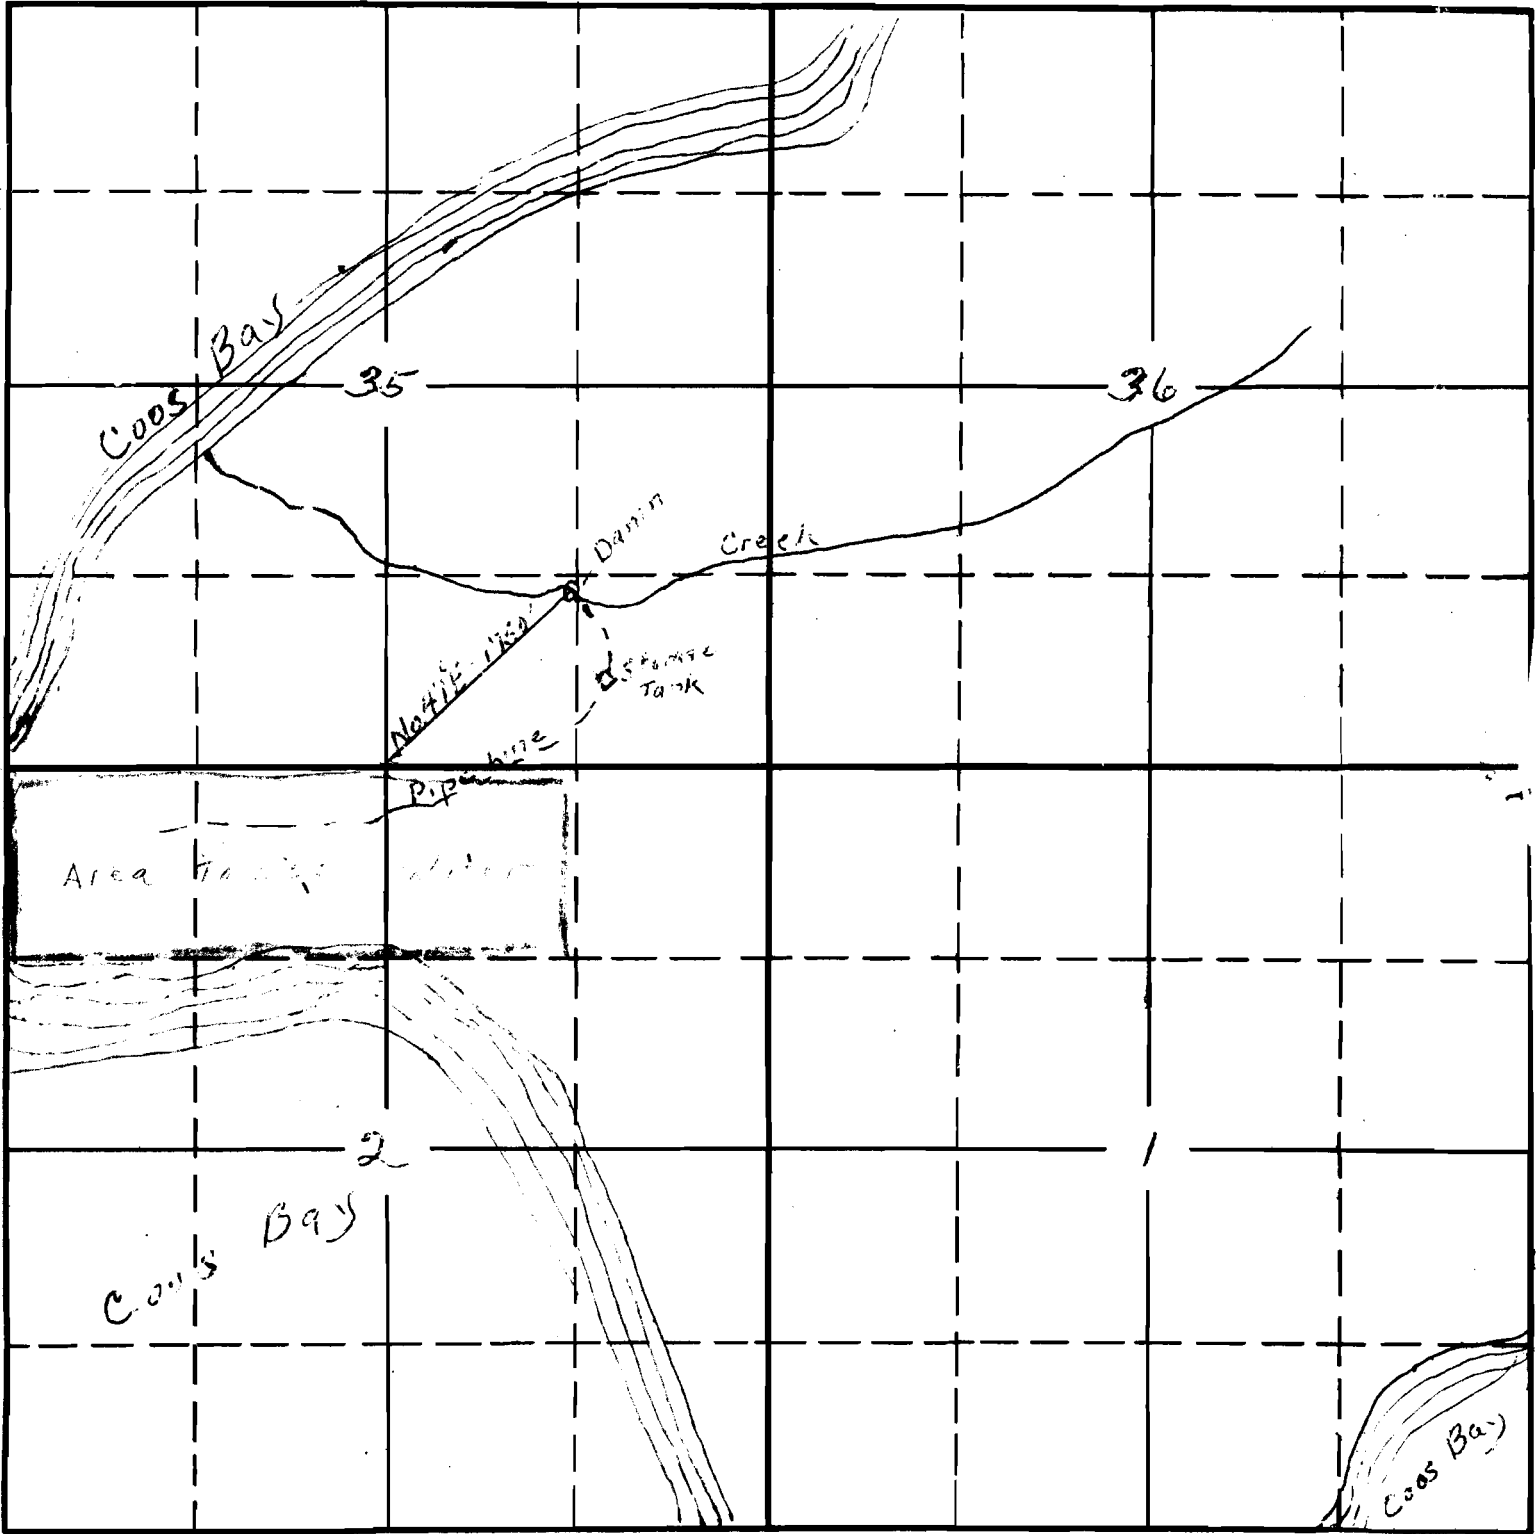

South

21487 17-1013

RECEIVED
FEB 12 1946
STATE ENGINEER
SALEM, OREGON

RECEIVED
MAR 12 1946
STATE ENGINEER
SALEM, OREGON

APPLICATION No. 21487
PERMIT No. 16853