


T2N, R4W, WM.

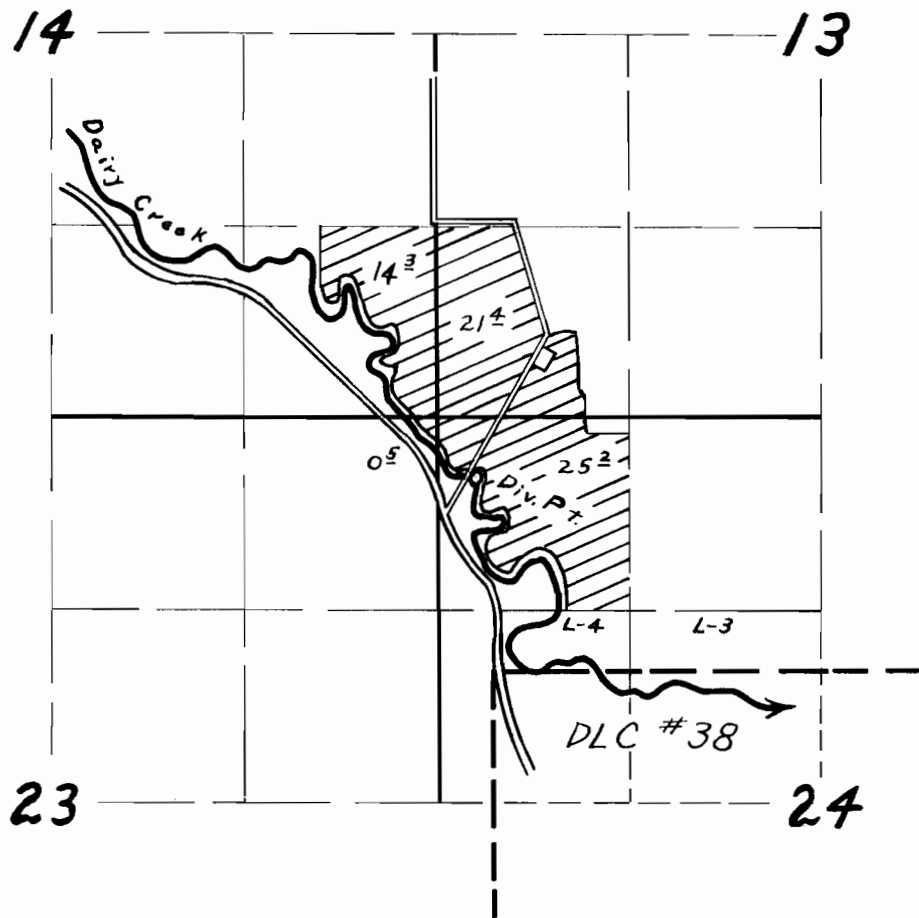

**FINAL PROOF SURVEY**  
UNDER

Application No. 22367 Permit No. 17634  
IN NAME OF

Charles Schmidlin

Surveyed 4-18 1956, by R.D. Best