


T1S, R3&4W, WM.

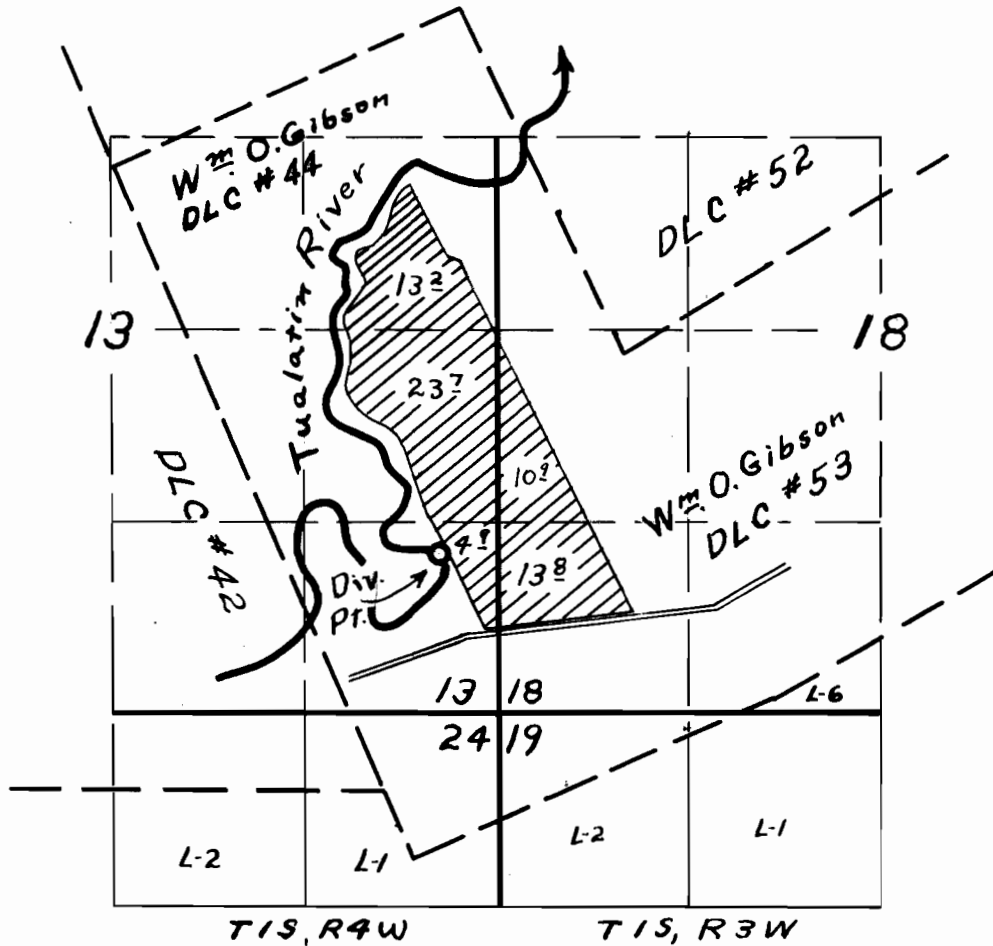

FINAL PROOF SURVEY

UNDER

Application No. 22373 Permit No. 17639

IN NAME OF

Alfred Vanaken

Surveyed 4-24 1956, by R.D. Best