


P. 18169
21989

T. 9 S. R. 21 E. W.M.

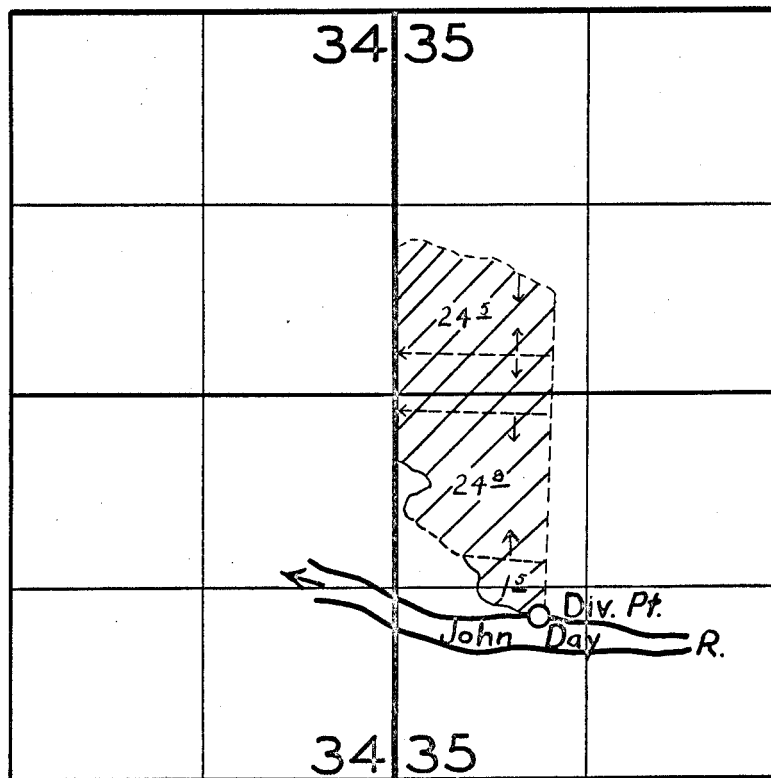

FINAL PROOF SURVEY
UNDER

Application No. 23093... Permit No. 18169...
IN NAME OF

MARGARET GRINDSTAFF

Surveyed 21 Apr. 1955, by T. Jones

DOV - 10H - 98

raw