


T. 9 S. R. 21 E. WM

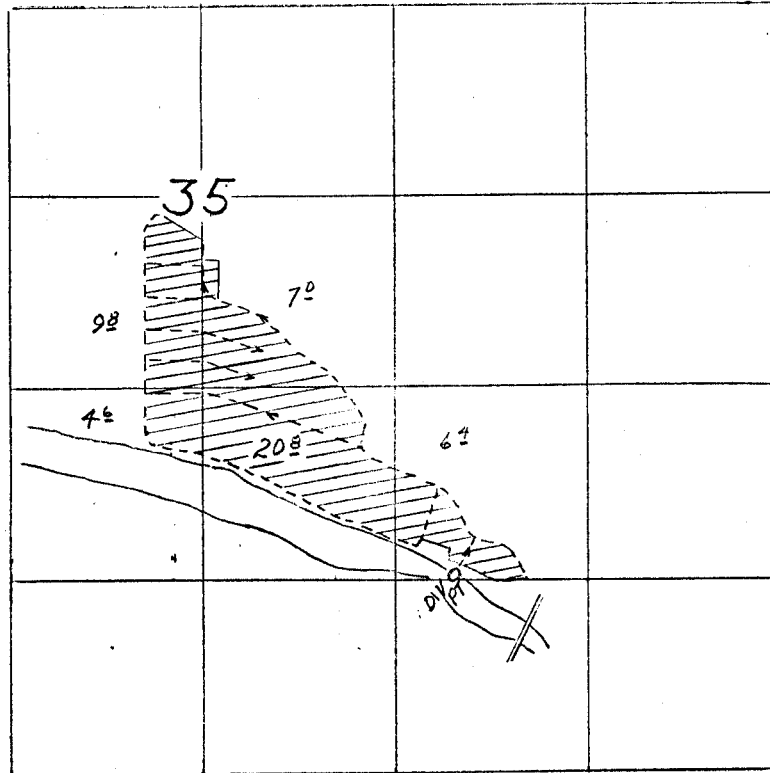

FINAL PROOF SURVEY

Under

Application 23094 Permit 18170
In name of

Margaret Grindstaff

Surveyed Apr. 21, 1955 by T. Jones