


T. 4 S. R. 5 W. W. M.

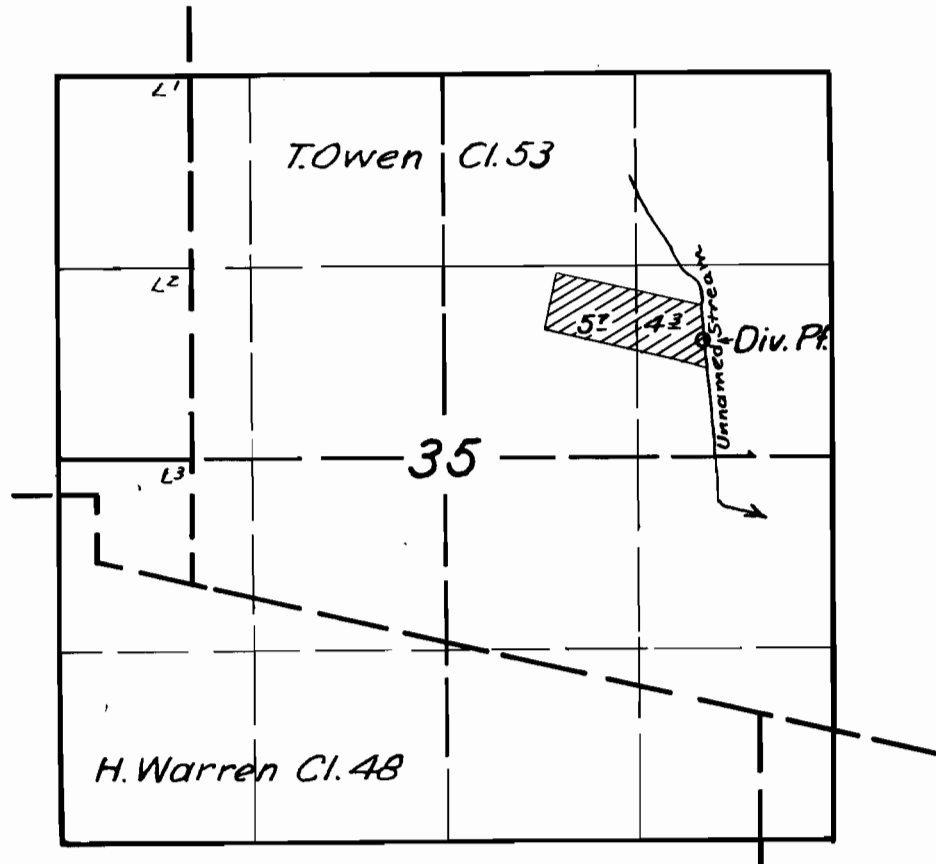

FINAL PROOF SURVEY
UNDER

Application No. 23375 Permit No. 18454
IN NAME OF

E. J. Handley

Surveyed Mar. 9 1956, by M. Bish