


T.3 S. R.3 W.W.M.

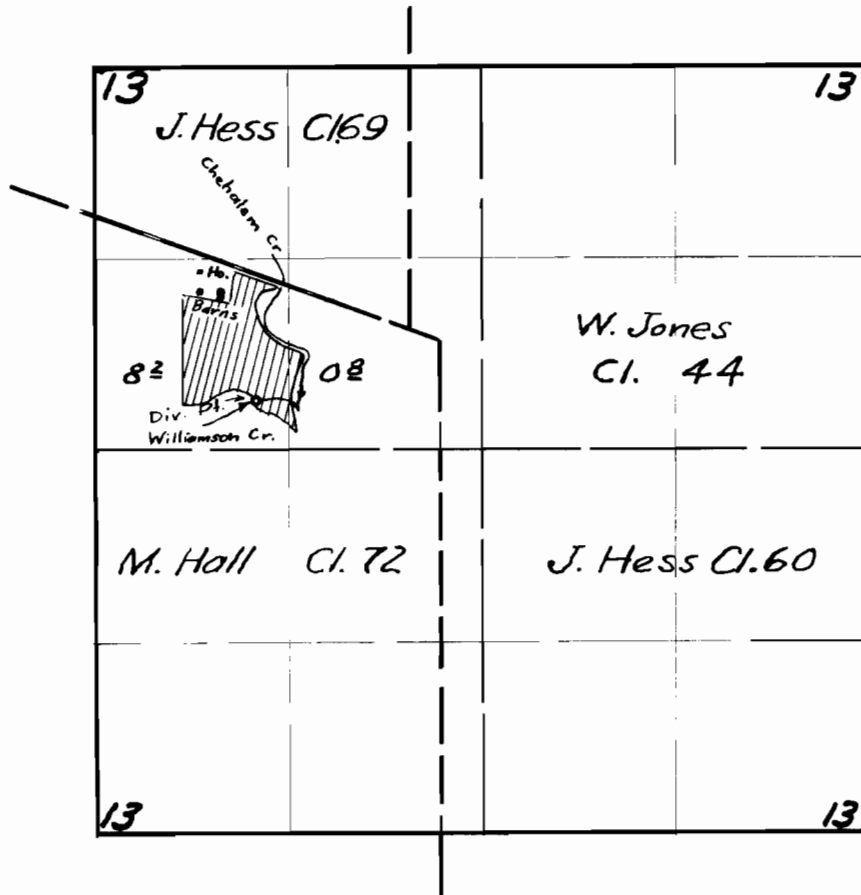

FINAL PROOF SURVEY

UNDER

Application No. 23615 Permit No. 18621

IN NAME OF

Arden Rusaw

Surveyed Mar. 22 1956, by Tr. Bish