


T1&2N, R4W, W.M.

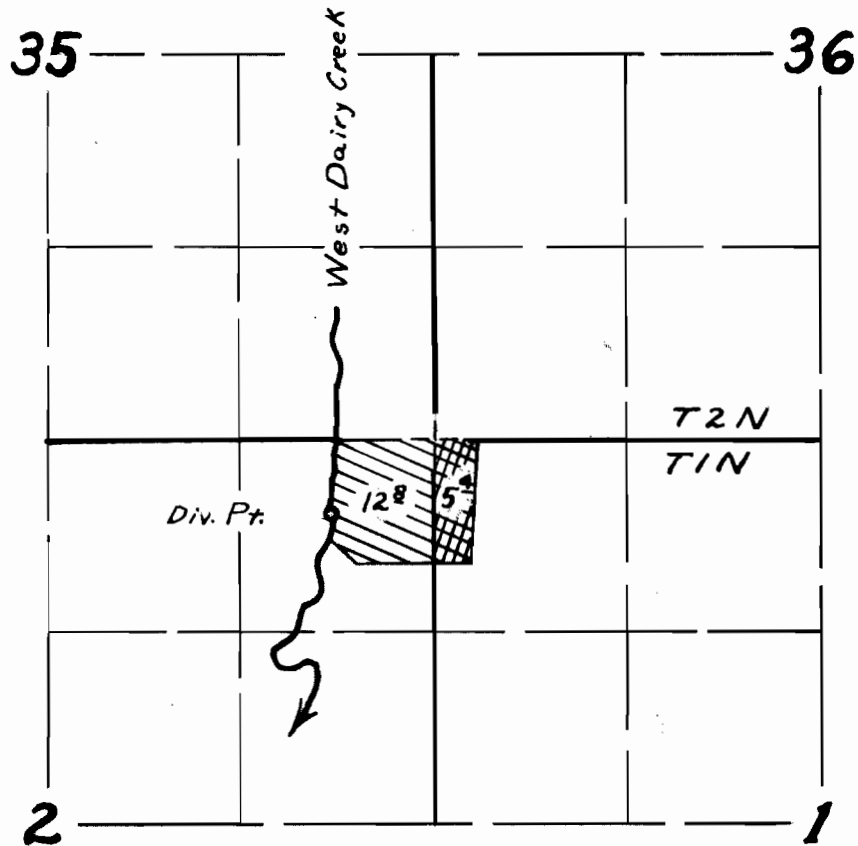

FINAL PROOF SURVEY

UNDER

23702

18718

Application No. 24782... Permit No. 19526...



IN NAME OF

W. L. Moore

Surveyed 4-12 1956, by R.H. Whitby