


TIN & 15, R4W, WM.

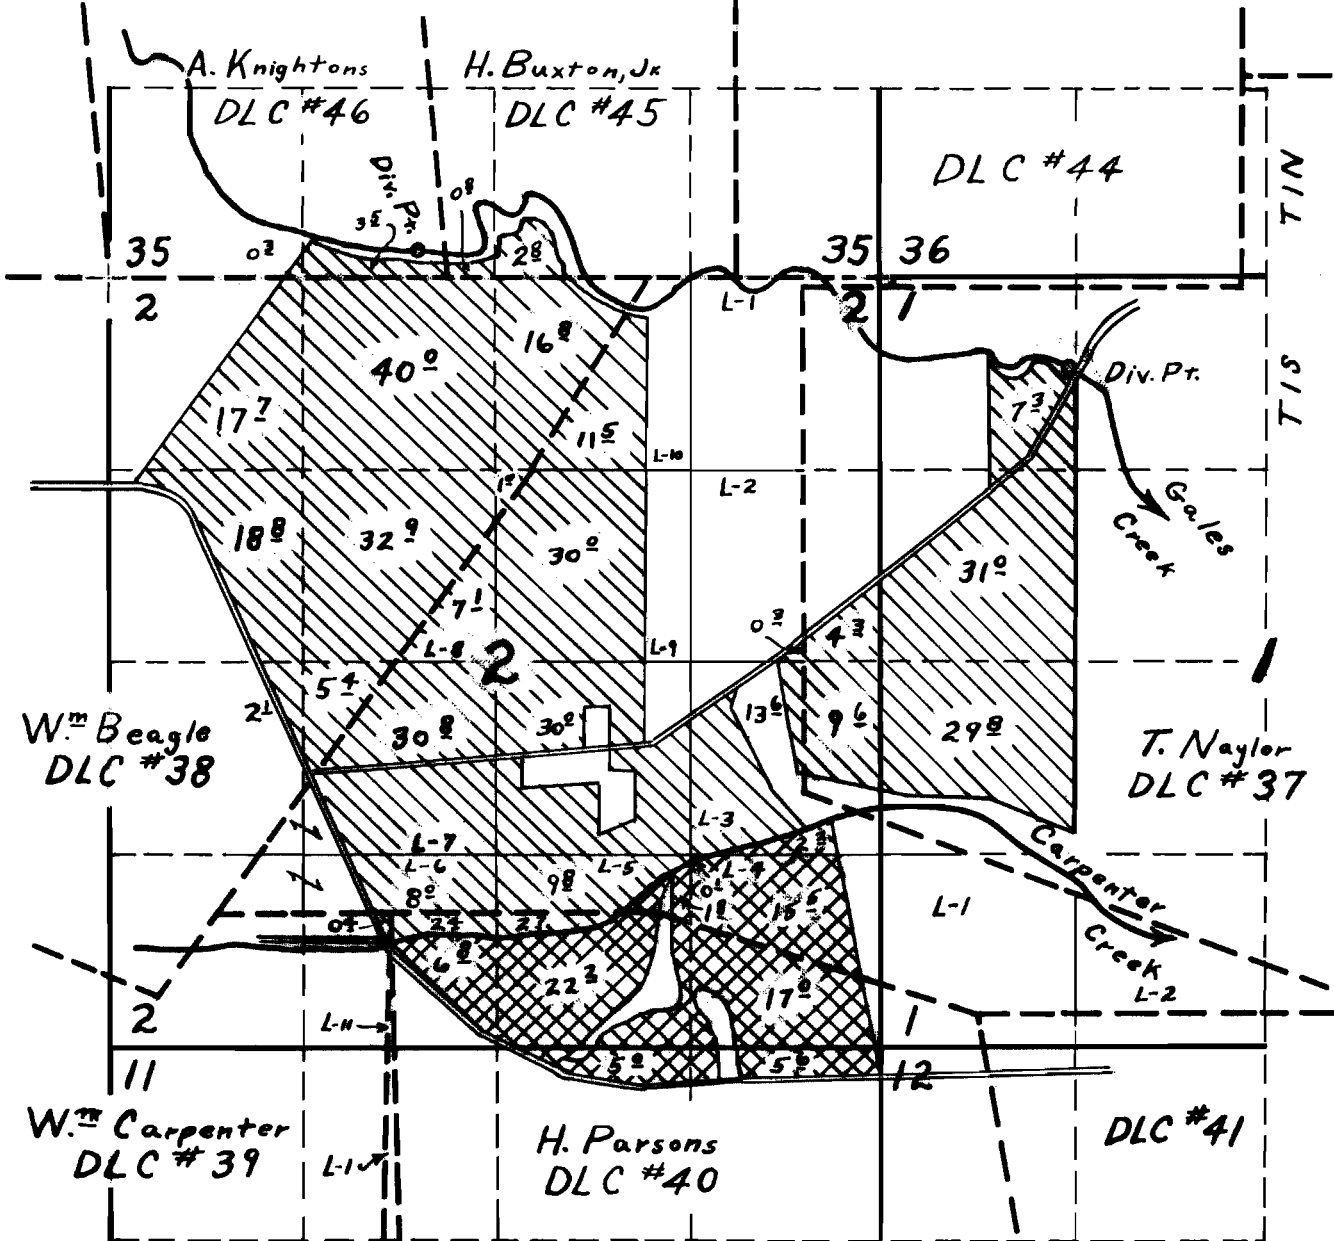

**FINAL PROOF SURVEY**  
UNDER

 Gales Creek  
 Carpenter Creek

Application No. 23839 Permit No. 18781  
IN NAME OF

Ritchey Bros.

Surveyed 4-19 1956, by R.D. Best