


T. 4 S. R. 4. W. W. M.

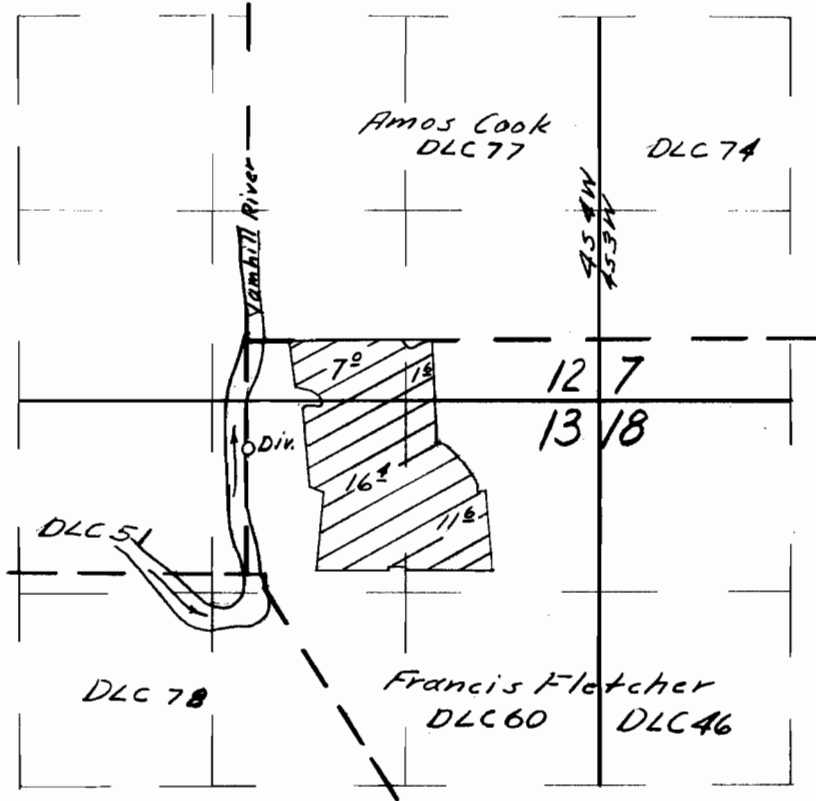

FINAL PROOF SURVEY
UNDER

Application No. 23871 Permit No. 18795
IN Name OF

Jack A. Wright & Son

Surveyed May 27, 1955 by T. Jones