


# T. 7S. R. 5W. WM

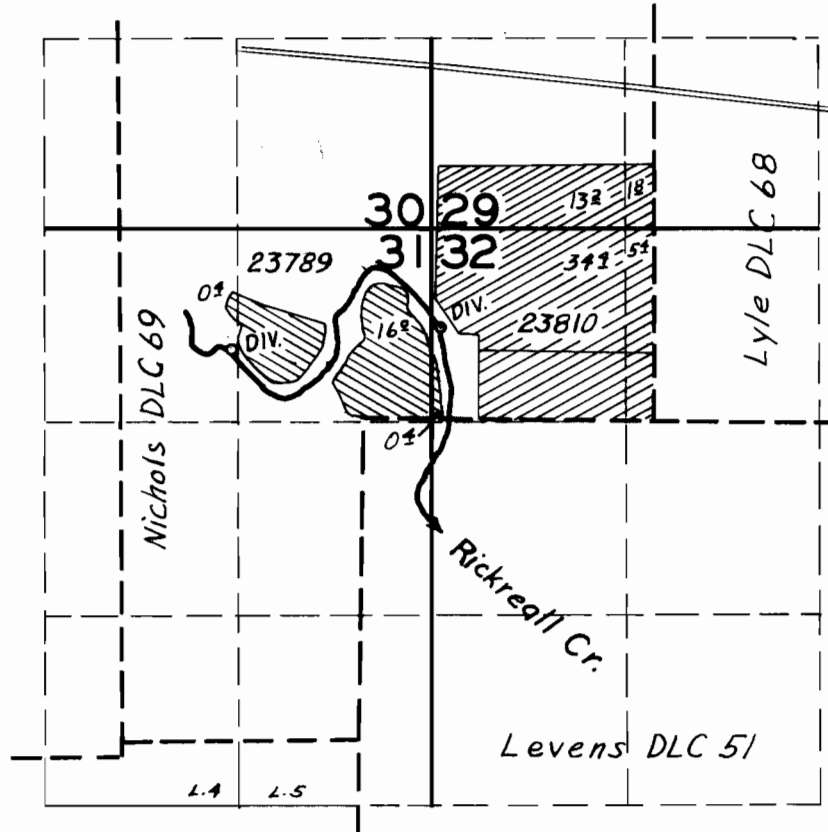

## FINAL PROOF SURVEY

UNDER

Application No. 23789 Permit No. 13092  
 23810 13085

IN NAME OF

W. B. Jordan  
 Earl Stonebrook

Surveyed Aug. 17 1955, by J. Jones

1-3-100  
 1-3-11