


T2N, R4W, WM

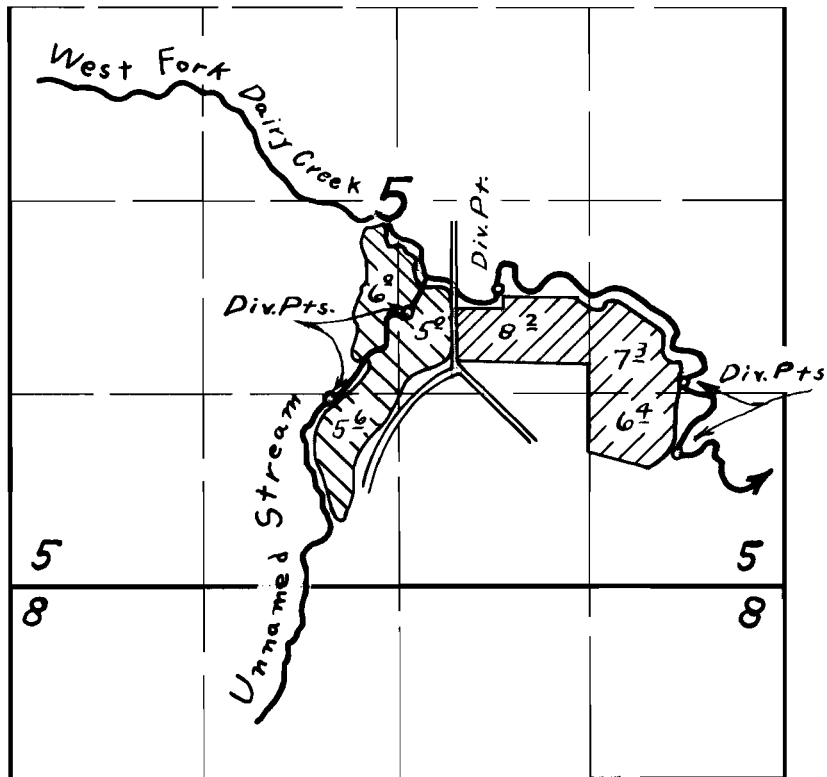

### FINAL PROOF SURVEY

UNDER

Application No. 24050 Permit No. 18952

IN NAME OF

Long Brothers Lumber Co.

Surveyed 4-17 1956, by R.D. Best