


T. 4 S. R. 4 W. W.M.

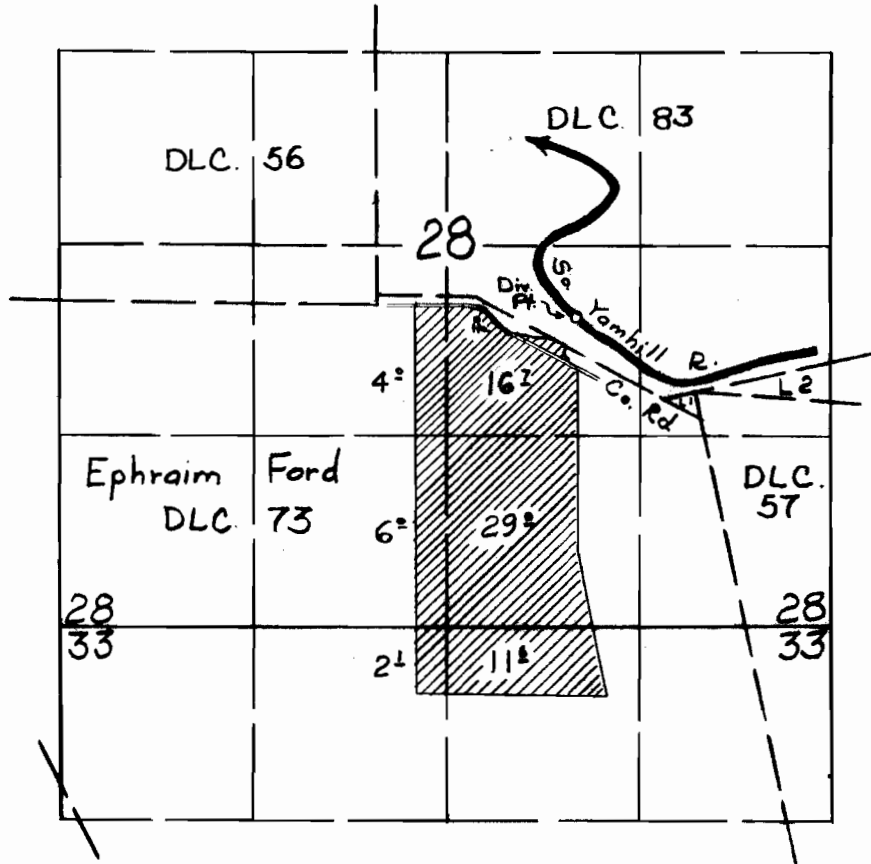

FINAL PROOF SURVEY  
UNDER

Application No. 24175 Permit No. 19011  
IN NAME OF

Chris Hansen

Surveyed 8 June, 1955 by T. Jones

DFQ-5D-64

RUN