


T. 6 S. R. 1 E. W.M.

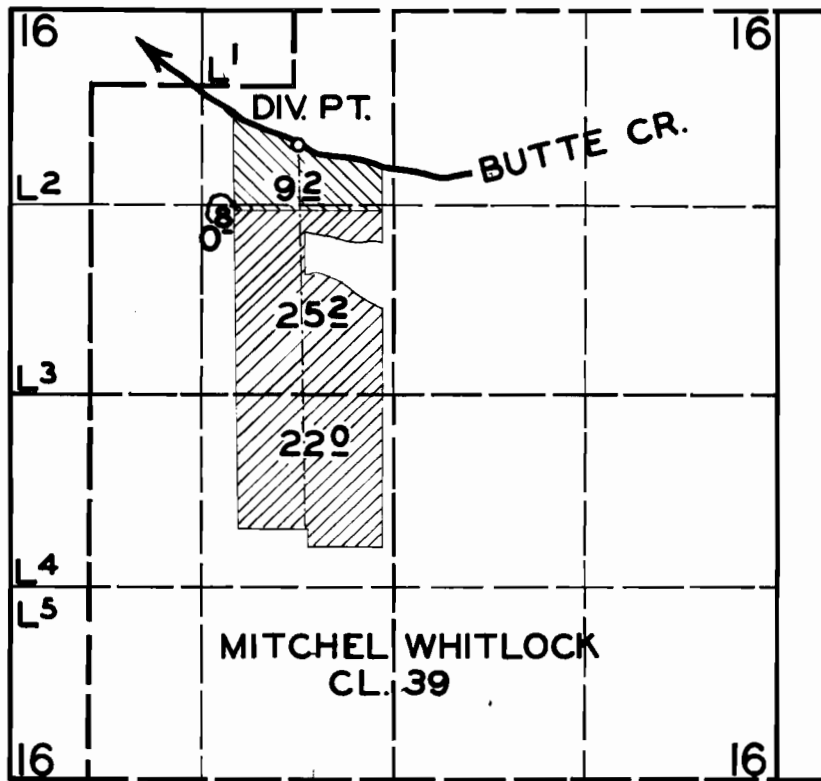

FINAL PROOF SURVEY

UNDER

24282

19050

Application No. 26316 Permit No. 20655



IN NAME OF

ALOIS IMPER

Surveyed 17 JULY 1956, by M. BISH