


T. 5 S. R. 6 W. W.M.

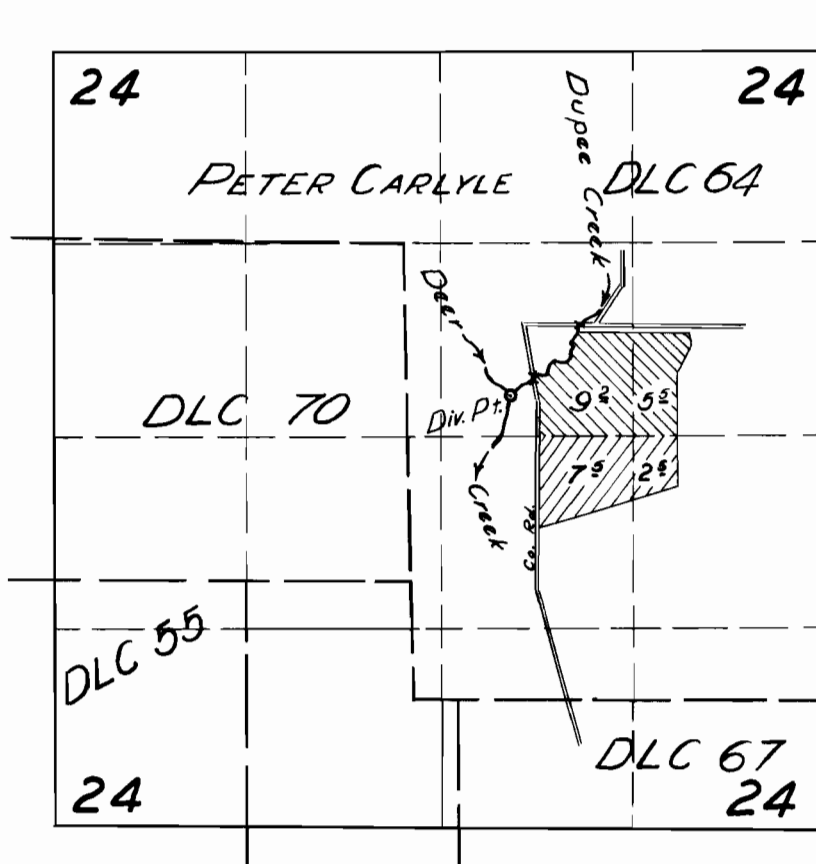

FINAL PROOF SURVEY

UNDER

23992

19100

Application No. 25458 Permit No. 20016



IN NAME OF

JACOB GRAUER

Surveyed 13 Mar. 1956, by *[Signature]*