


T.5S.R.4 WWM

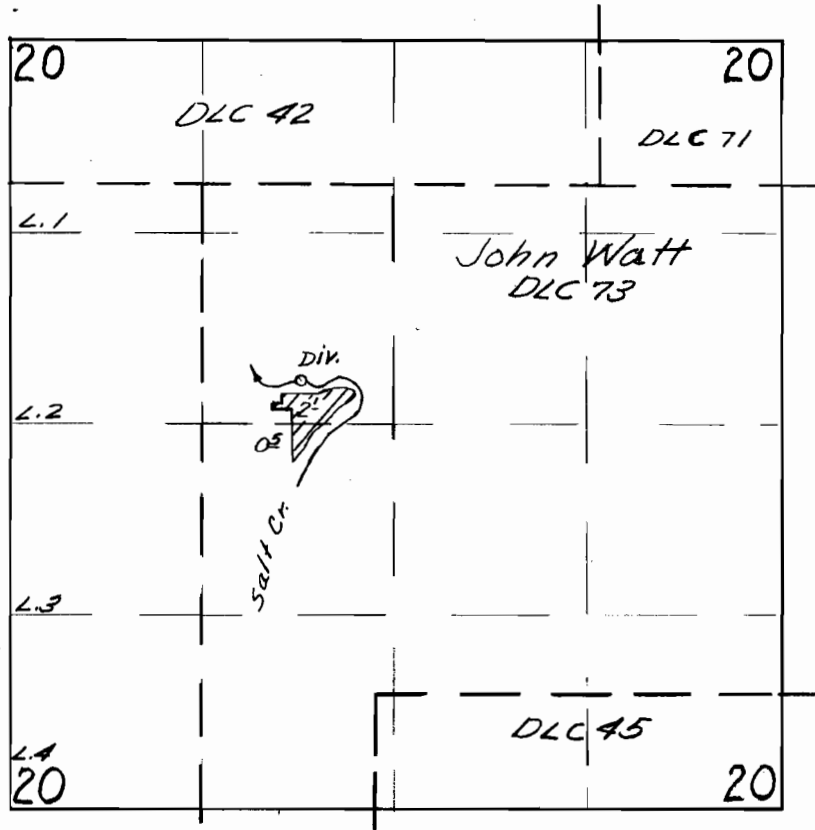

FINAL PROOF SURVEY

Application No. 24283 Permit No. 19218  
IN NAME OF

Joe Burns

Surveyed May 19, 1956, by T. Jones