


T. 5 S. R. 3 W. W.M.

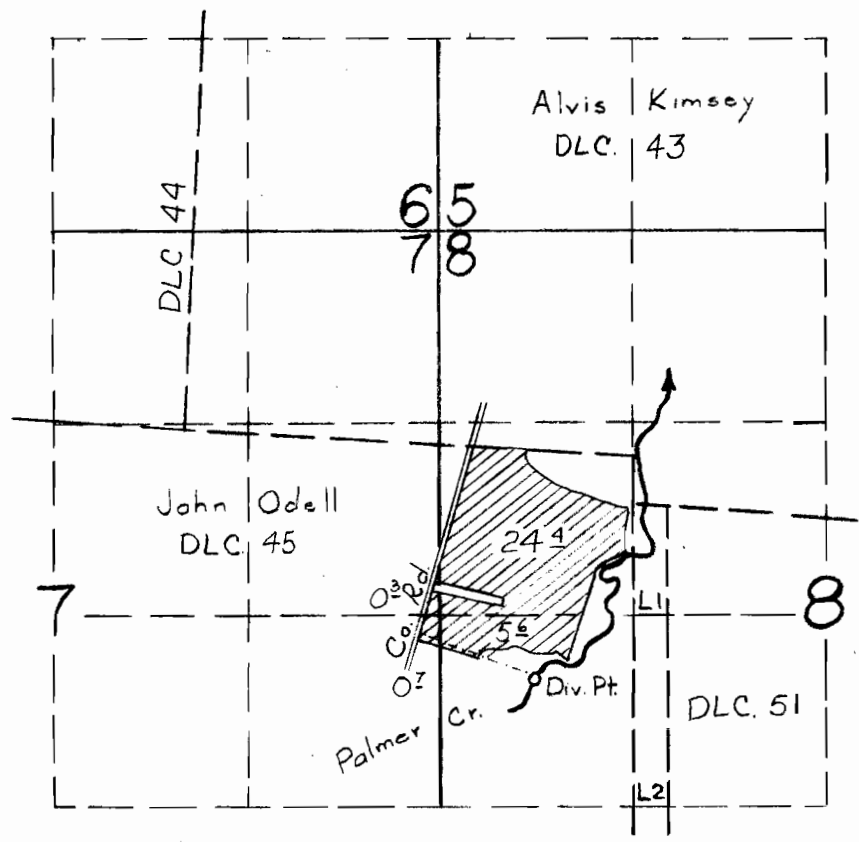

FINAL PROOF SURVEY  
UNDER

Application No. 24526 Permit No. 19312  
IN NAME OF

Charley Carr

Surveyed 25 May, 1955, by T. Jones