


T. 2 S. R. 5 W.W.M.

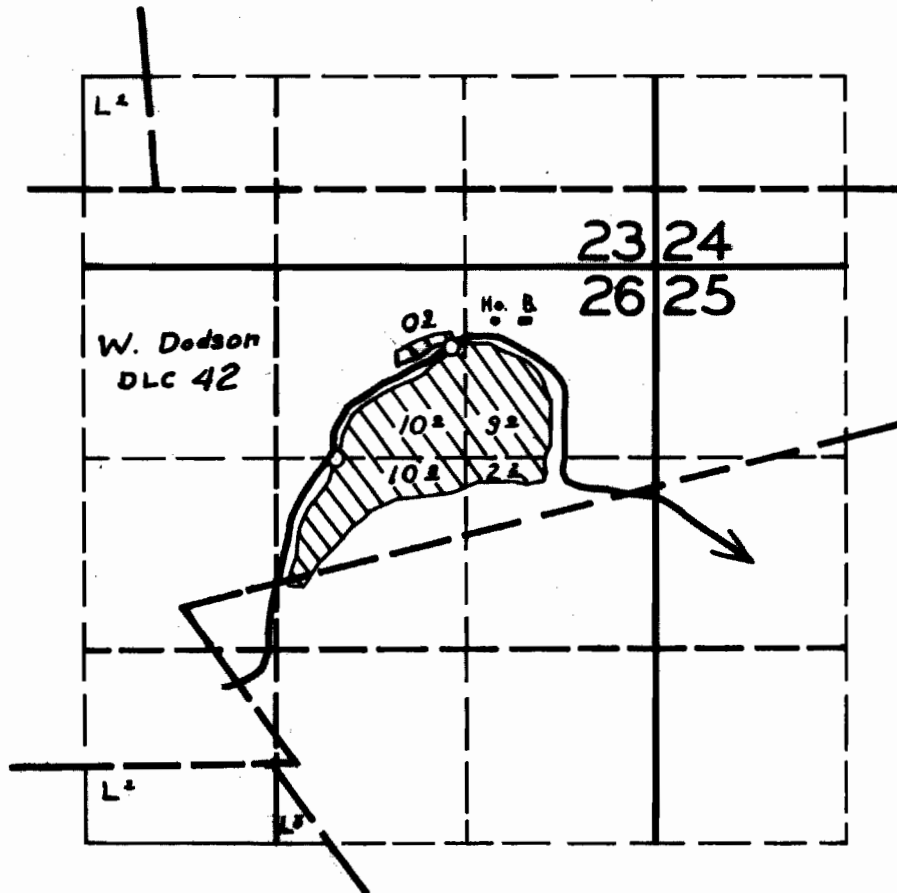

FINAL PROOF SURVEY

UNDER

Application No. 24534 Permit No. 19358

IN NAME OF

FRANK MILLS

Surveyed 2 May 1965, by H. Coffman

DFR- 3D- 08

200