


T. 4 S. R. 3 W. W. M.

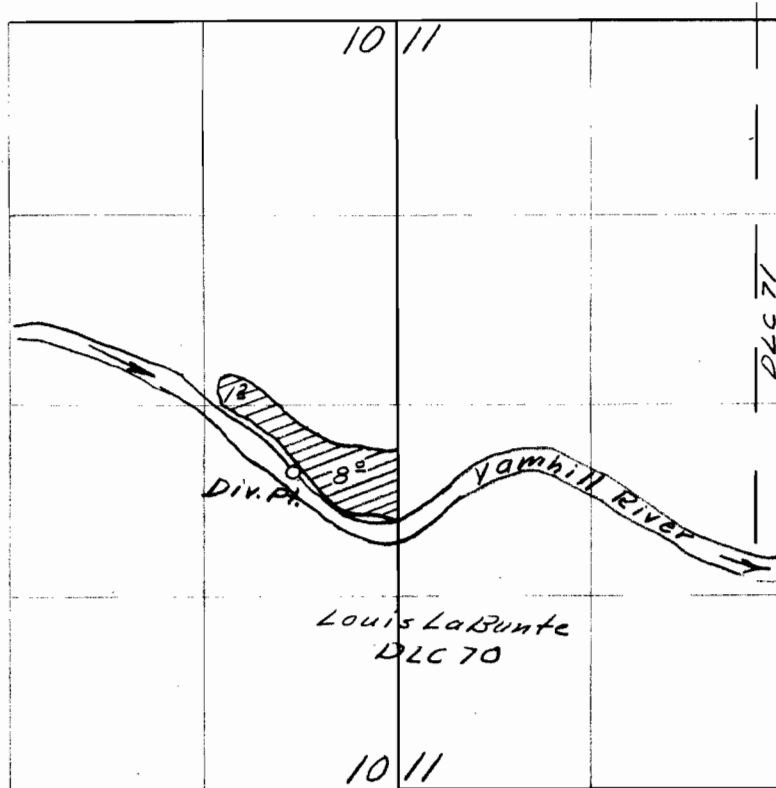

Final Proof Survey
Under

Application No. 24659 Permit No. 19402
IN NAME OF

Roy Dundas

Surveyed June 7 1955 by T. Jones