


TIN, R4W, WM.

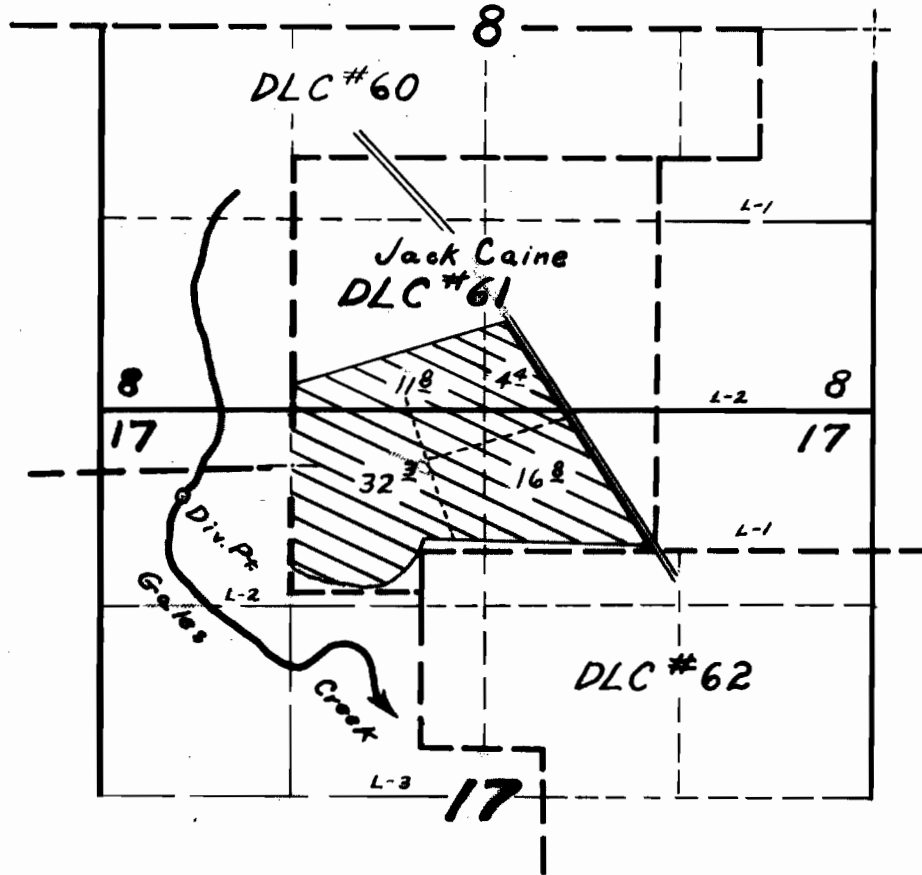

**FINAL PROOF SURVEY**

UNDER

Application No. 24724 Permit No. 19424

IN NAME OF

H.D. Parson

Surveyed 4-11 1956 by R.D. Best