


T 1 S, R 3 W, WM

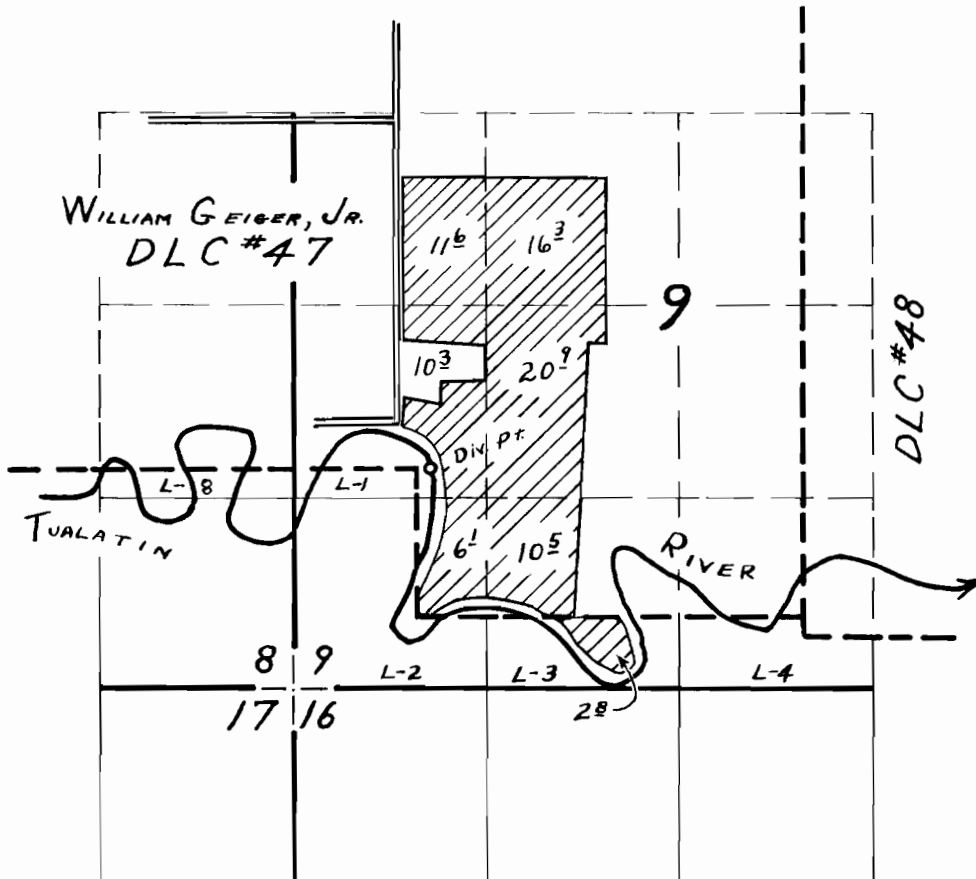

FINAL PROOF SURVEY

UNDER

Application No. 24884 Permit No. 19610

IN NAME OF

F. W. HERING

Surveyed 5-1 1956, by R. D. BEST