


TIS R3WWM

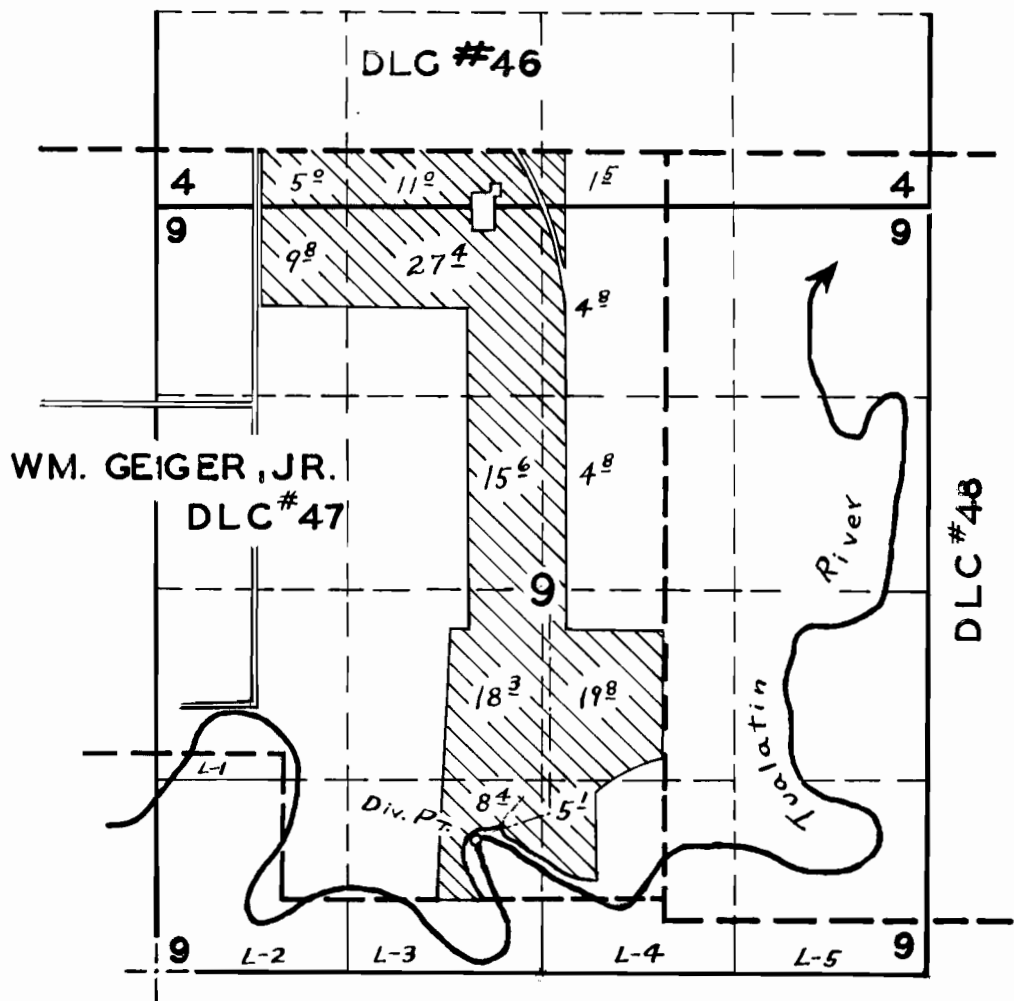

FINAL PROOF SURVEY

UNDER

Application No. 24985 Permit No. 19611

IN NAME OF

DAVID SAUCY, JR. & JEANETTE O. SAUCY

Surveyed 5-3 1956 by R. WHITBY