


T 1 S R 3 W W M

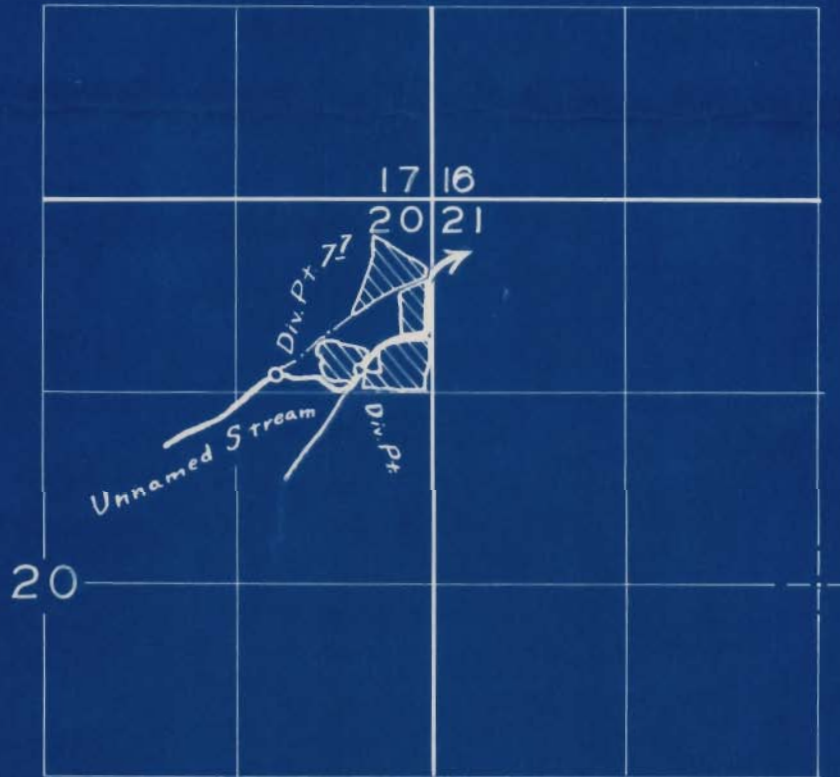

**FINAL PROOF SURVEY**

UNDER

Application No. 24956 Permit No. 19693

IN NAME OF

SARA SOOK

Surveyed 5-4 1956, by R. D. BEST