


T2N, R4W, WM.

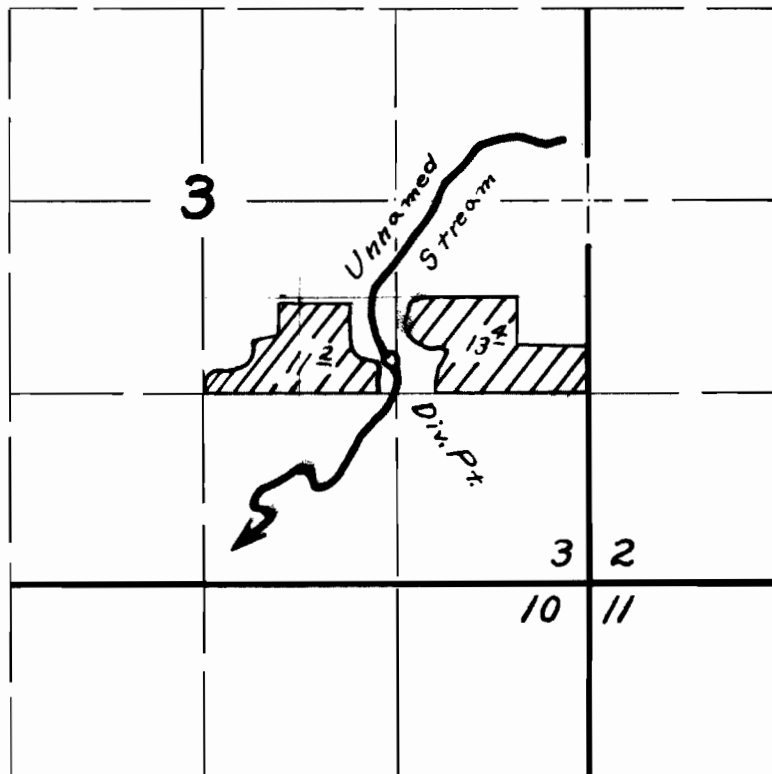

FINAL PROOF SURVEY
UNDER

Application No. 25123 Permit No. 19808
IN NAME OF

R.C. Wambaugh

Surveyed 4-17 1956, by R.D. Best