


T1N, R4W, WM

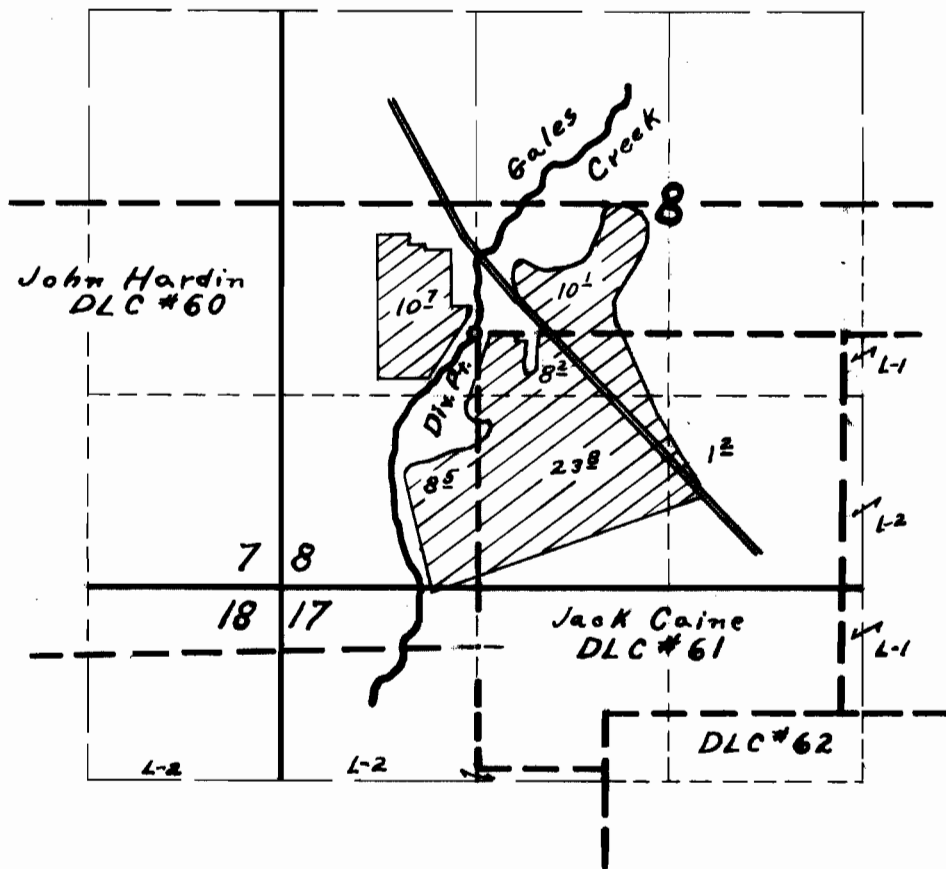

FINAL PROOF SURVEY
UNDER

Application No. 25246 Permit No. 19832
IN NAME OF

.....Heisler Brothers.....

Surveyed 4-12 1956, by R.D.Best.....