


T. 4 S., R. 4 W., W. M.

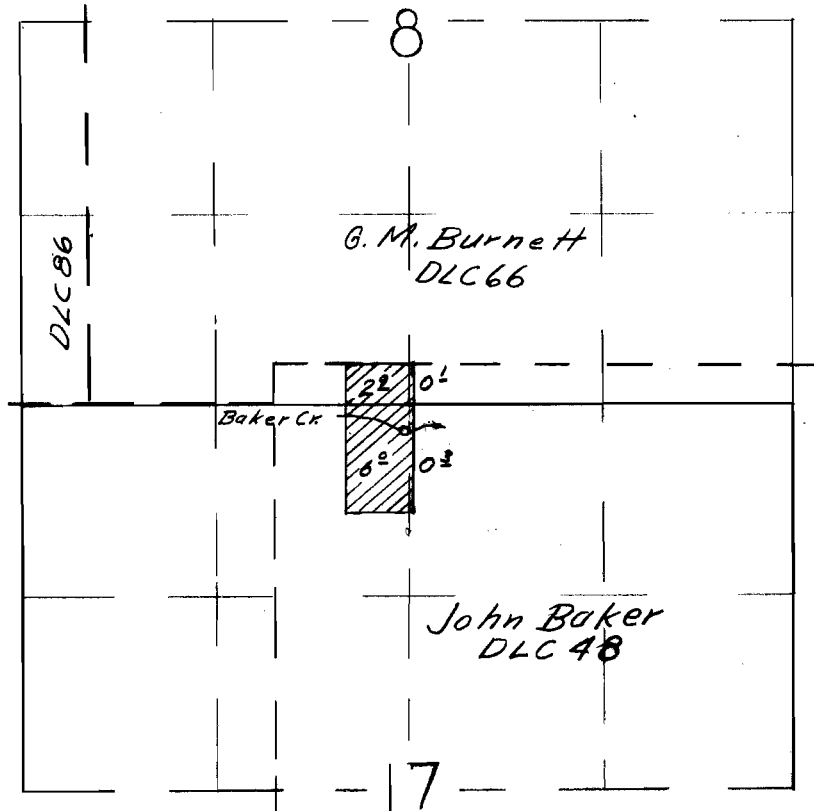

Final Proof Survey
Under

Application No. 25260 Permit No. 19843
In Name Of

H. P. & Alice K. Mahon

Surveyed July 1 1955 by T. Jones