


T. 4 S. R. 4 W. W. M.

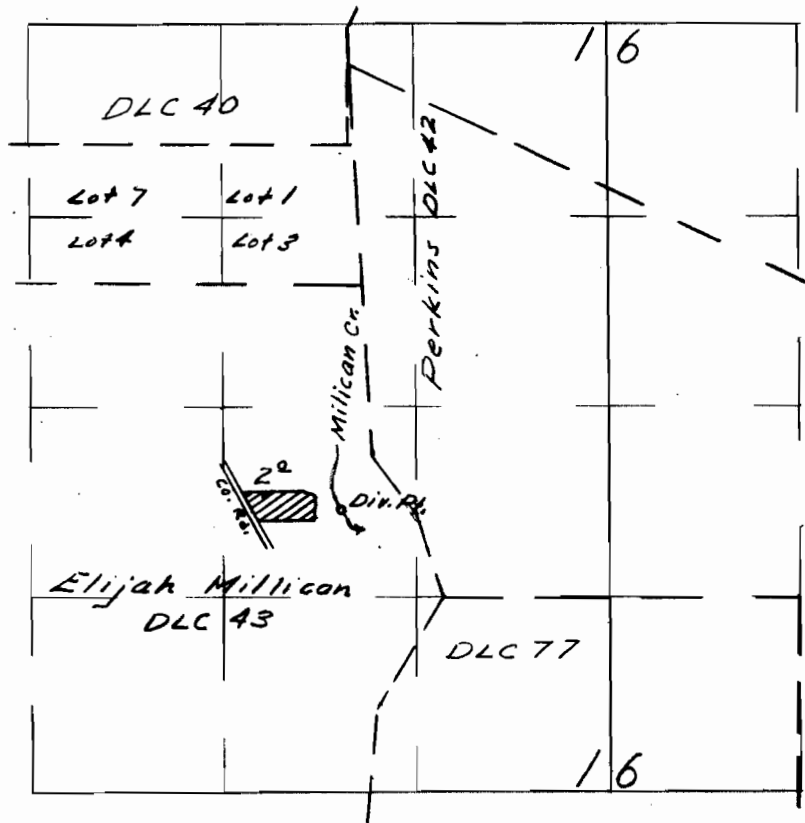

Final Proof Survey
Under

Application No. 25586 Permit No. 20081
In Name Of

Frank Belts

Surveyed June 1 1955 by T. Jones