


T1&2N, R4W, WM

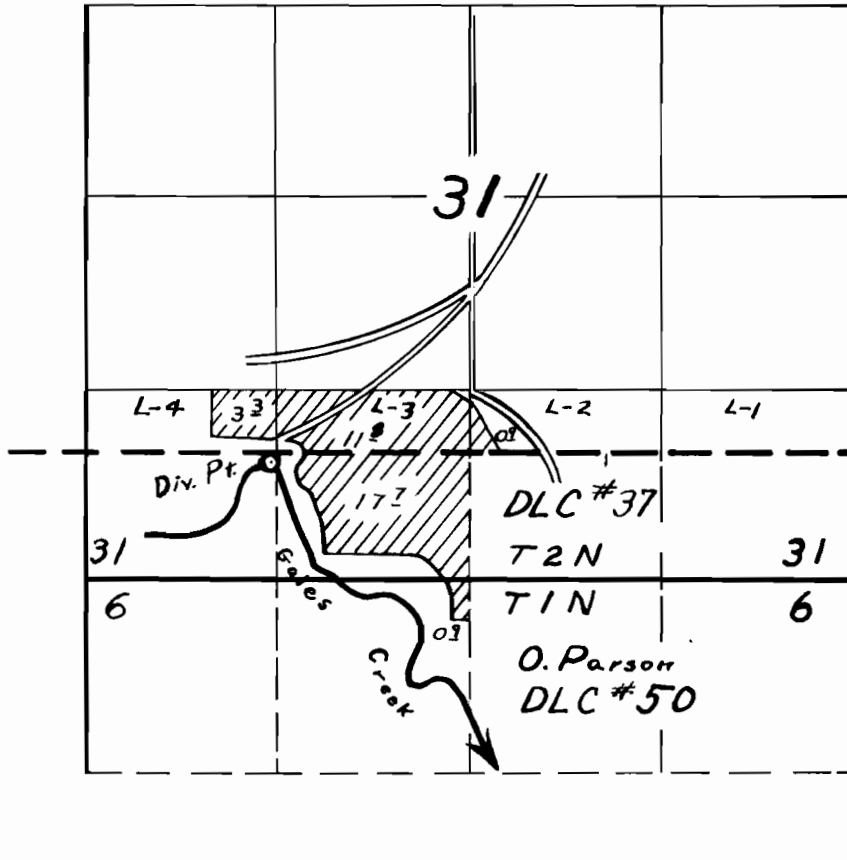

FINAL PROOF SURVEY

UNDER

Application No. 25688 Permit No. 20135

IN NAME OF

MELVIN N. OBERG

Surveyed 4-12 1956 by R.D.B.E.S.T.