


T. 5 S. R. 3 W. W. M.

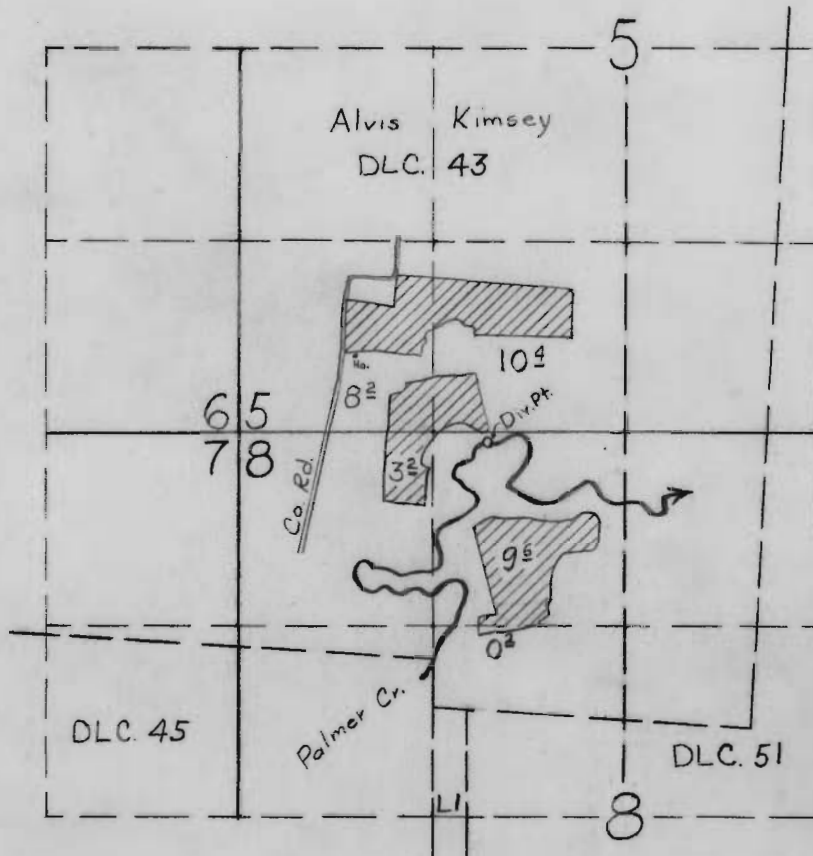

FINAL PROOF SURVEY  
UNDER

Application No. 25545 Permit No. 20165  
IN NAME OF

Frank Armentrout

Surveyed 25 May, 1956 by T. Jones