


T. 29 S., R. 4 W. W.M.

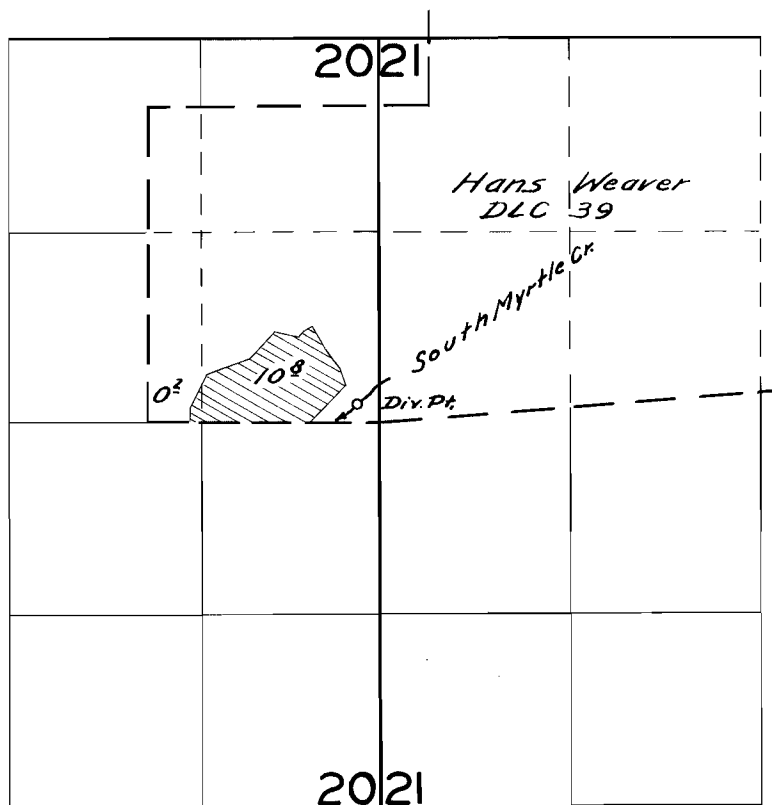

FINAL PROOF SURVEY
UNDER

Application No. 25891 Permit No. 20318
IN NAME OF

Frank L. Radford

Surveyed Aug. 31, 1956, by C.O. Bartels