


T. 4 S. R. 4 W. W.M.

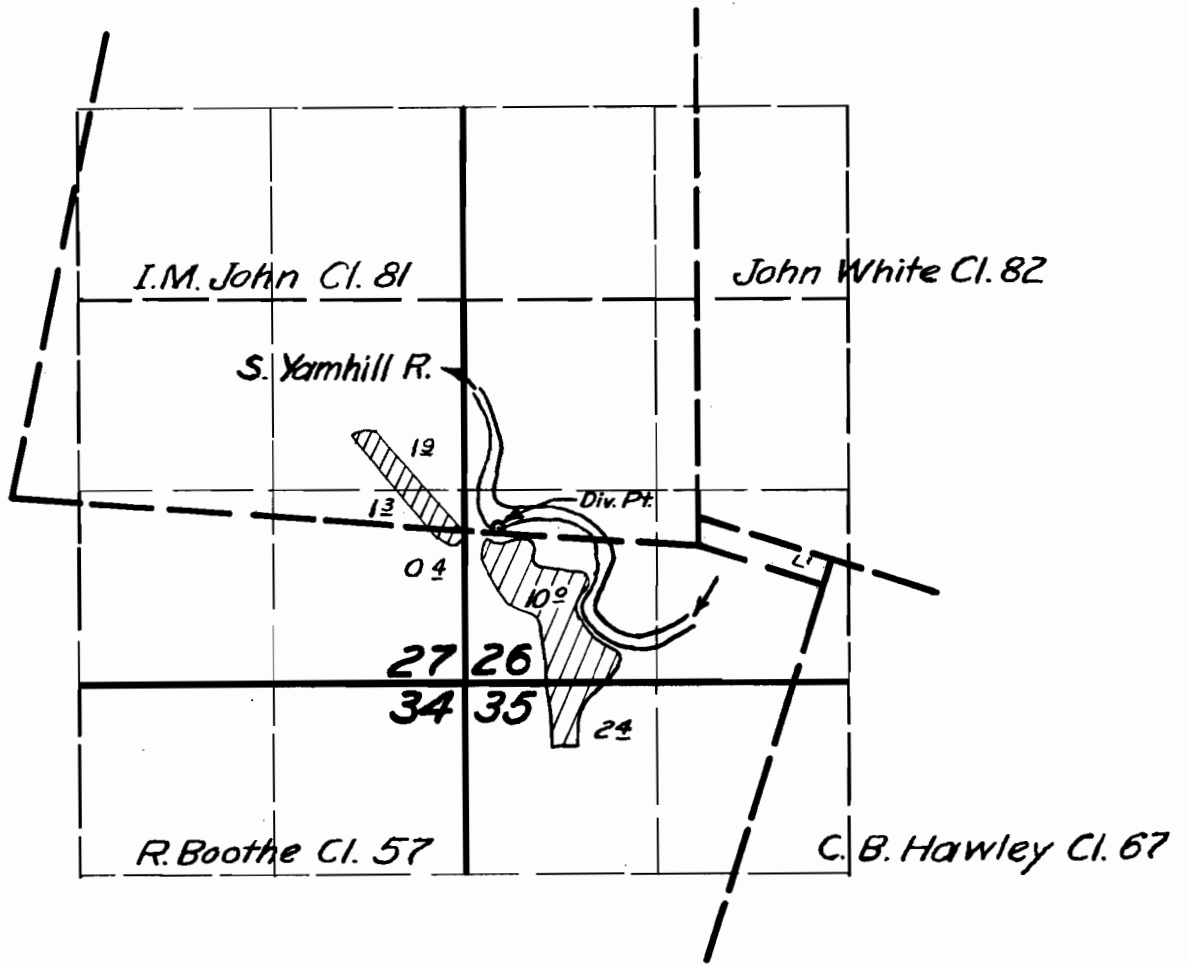

FINAL PROOF SURVEY

UNDER

Application No. 25909 Permit No. 20325.

IN NAME OF

Elmer G. Olsen & Marian C. Olsen

Surveyed Mar. 9, 1956, by M. Bish