

1948

T. 12 S. R. 22 E. W.M.

S.E. 1/4 - S.W. 1/4
Sec. 6.

C.P. Strum

Bridge Creek

S.W. 1/4 - S.W. 1/4
Sec. 6

A.W. Weinberger

End of Ditch

6.10 A.

4.94 A.

N. 27 1/2° W. - 500'

N. 22 3/4° W. - 420'

N. 1 3/4° E. - 400'

N. 2 3/4° E. - 520'

I, H.F.C. Heitmann, of Fossil, Oregon, do hereby certify that this map was made from notes taken during actual survey made by me on February 17th 1914, and that it correctly represents the works described in the accompanying application, together with the location of streams and other articles in the immediate vicinity, and has written thereon the area in each smallest subdivision which it is proposed to irrigate.
H.F.C. Heitmann
Surveyor.

1948

10
40

APPLIC. FOR PAT. No. 3499
PATENT No. 1918

N. 1 3/4° E. - 400'

N. 3 3/4° E. - 520'

N. 4 3/4° E. - 385'

N. 14 1/4° E. - 66'

N. 21 1/2° E. - 640'


N. 16 1/2° E. - 350'

N. 12° E. - 340'

N. 29° E. - 158'

North - 280.5'

N.W. 1/4 - S.W. 1/4
Sec. 7

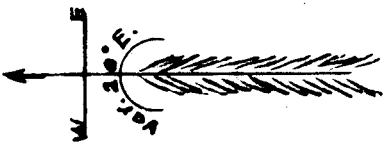

1" = 400'

Range line betw. 21 & 22E.

1/4

Taylor & Sheppard - West Ditch

M: 22 W

Bridg. C.

Headgate of Shrum & Weinberger Ditch

7

10
40