


T.4S. R.3W.W.M.

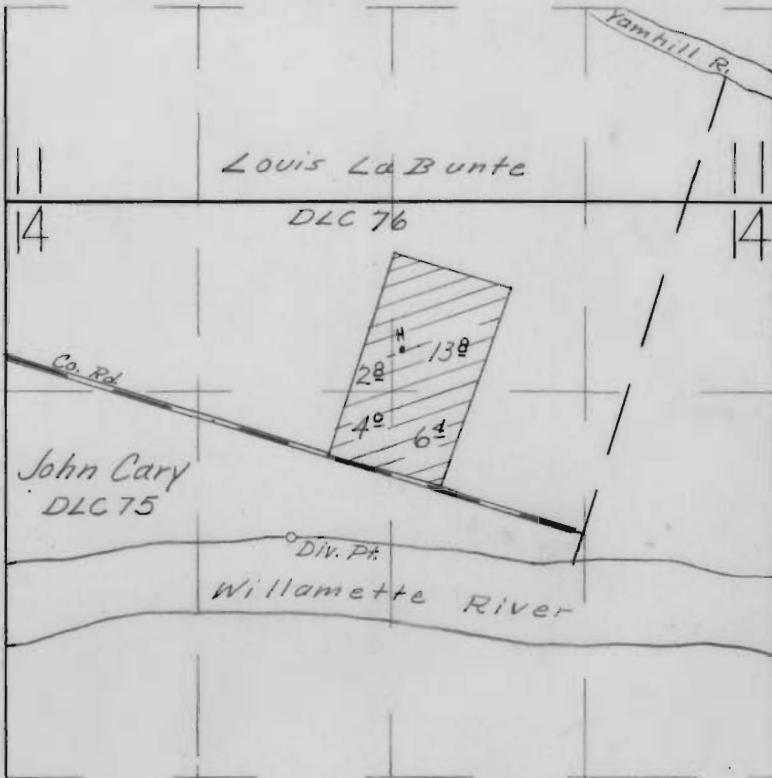

Final Proof Survey
UNDER

Application No. 26161 Permit No. 20420
In Name Of

Wayne A. Owens

Surveyed June 8 1955 by T. Jones