


T. 5 S. R. 3 W. W.M.

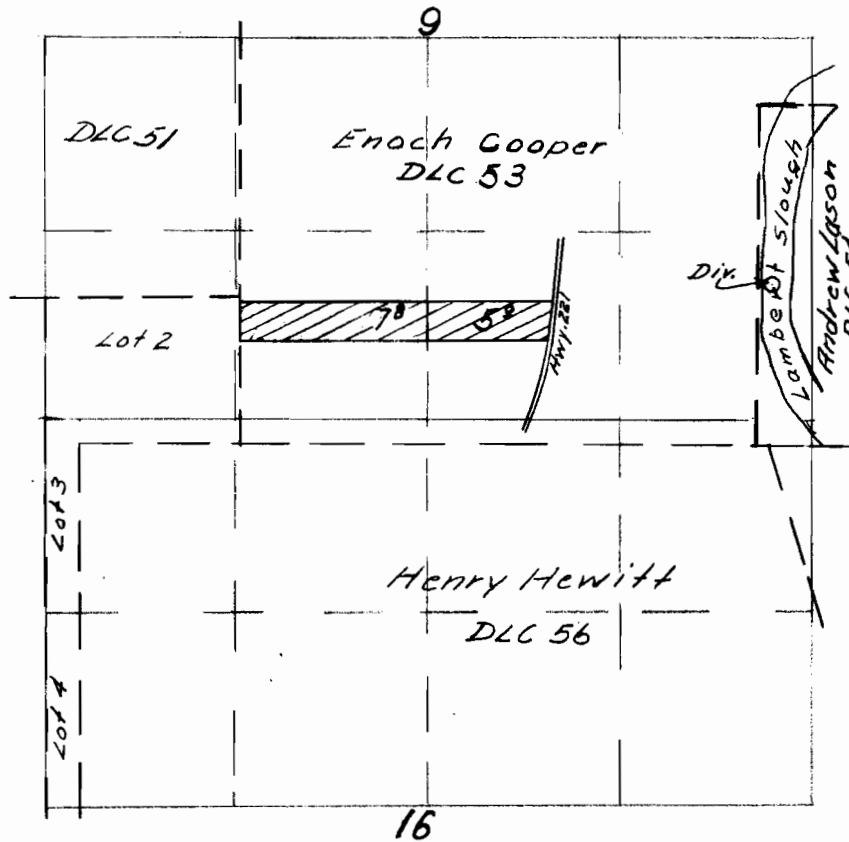

FINAL PROOF SURVEY  
UNDER

Application No. 25896 Permit No. 20537  
IN NAME OF

*Howard and Magalene Baker*

Surveyed May 1925, by T. Jones