


T 1 S, R 3 W, WM

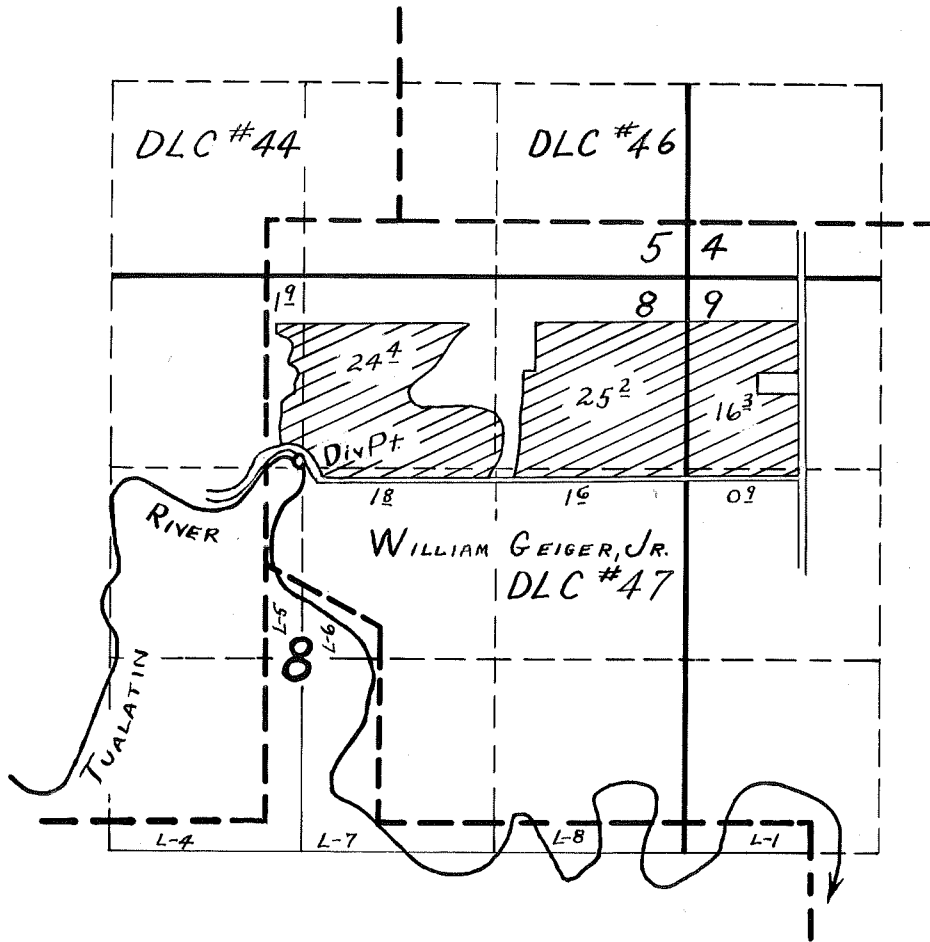

FINAL PROOF SURVEY
UNDER

Application No. 26463 Permit No. 20745
IN NAME OF

RUSSELL A. COWAN

Surveyed 5-2 1956, by R.D.B.E.S.T.