


T. 4 S. R. 1 W. W.M.

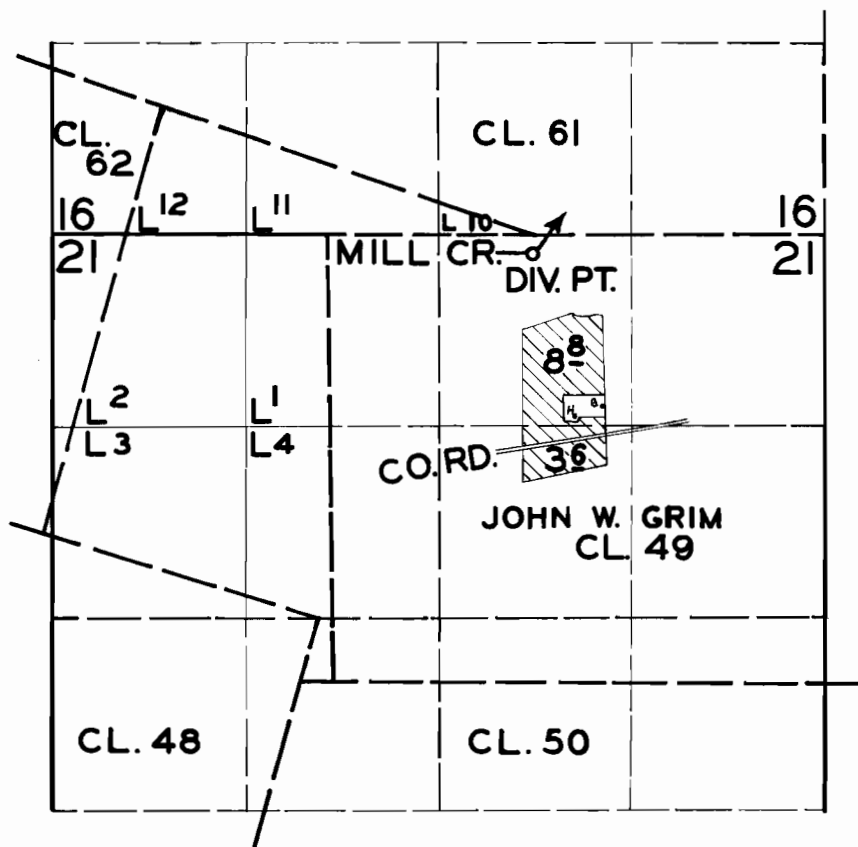

**FINAL PROOF SURVEY**  
UNDER

Application No. **26594** Permit No. **20831**  
IN NAME OF

**HENRY & NELLIE M. MOORE**

Surveyed **20 SEPT 1956**, by **M. BISH**

*[Handwritten mark]*