


T. 5 S. R. 3 W. W. M.

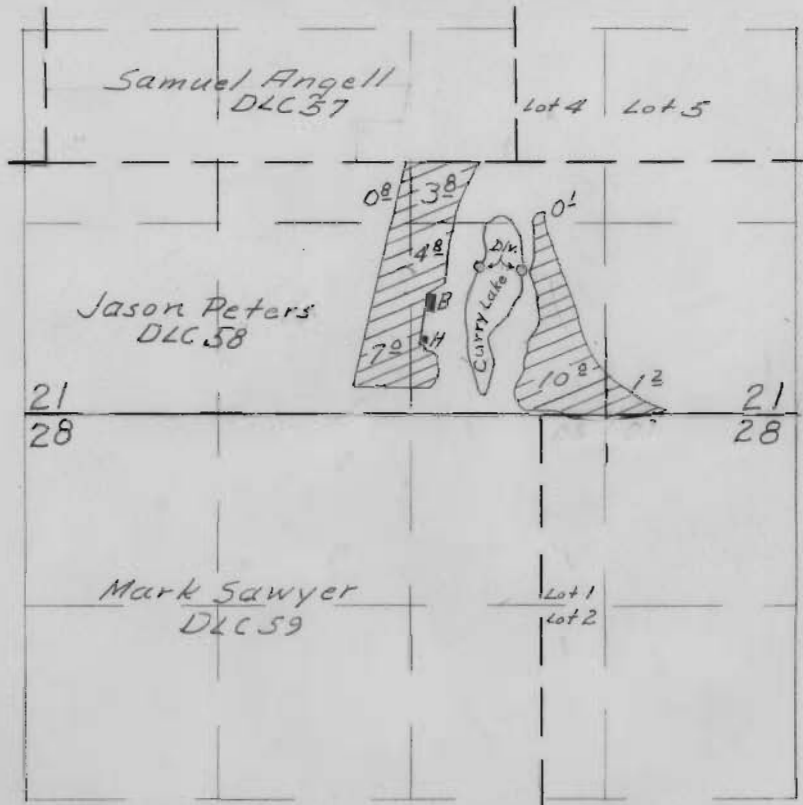

FINAL PROOF SURVEY

UNDER

Application No 26754 Permit No 20932

IN NAME OF

Ered R. & Emily M. Rohde & Dwight & Minnie Manning

Surveyed May 26 1956, by T. Jones