


T1S, R3W, WM

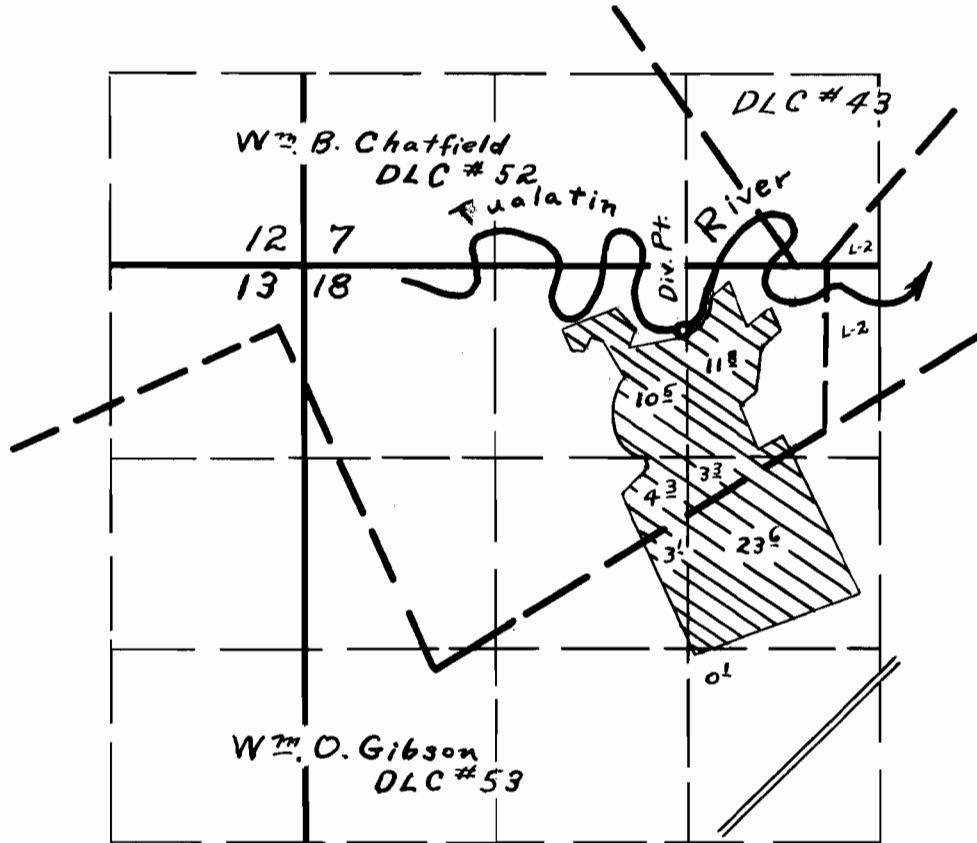

FINAL PROOF SURVEY
UNDER

Application No. 25860 Permit No. 20982
IN NAME OF

T.L. Lebeck

Surveyed 5-1 1956 by R.D. Best

