


T.8S.R.5W.WM

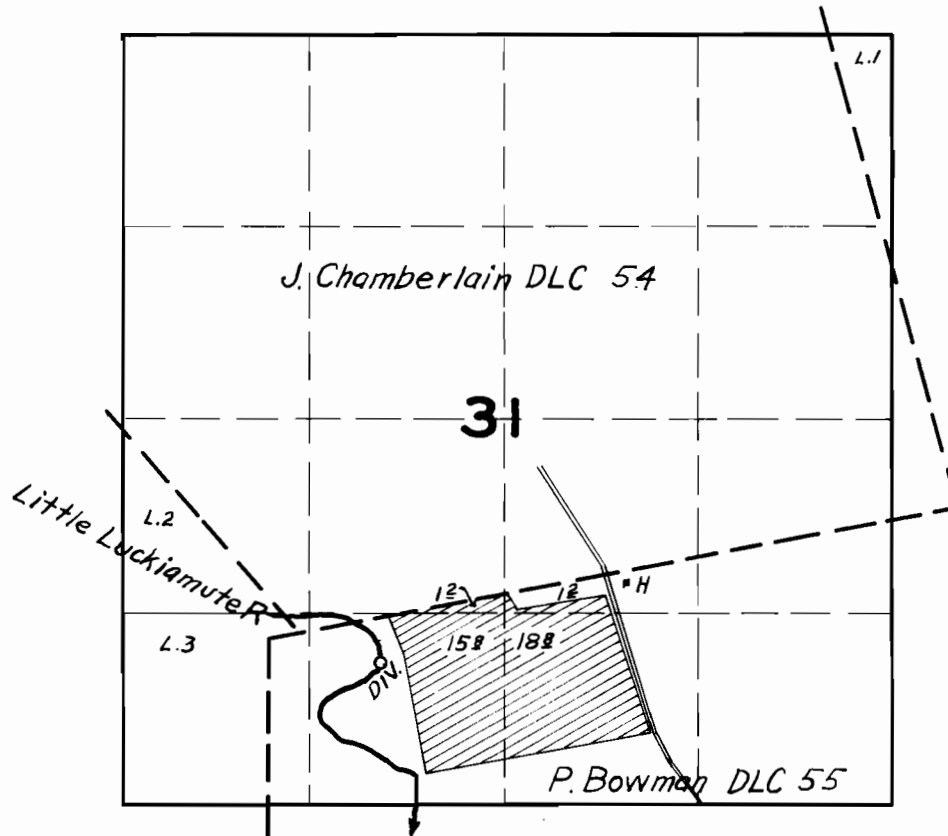

FINAL PROOF SURVEY

UNDER

Application No. 26776 Permit No. 21037

IN NAME OF

Neil Rice

Surveyed Aug. 5, 1954, by T. Jones

DFW-37-21