


T1S, R4W, WM.

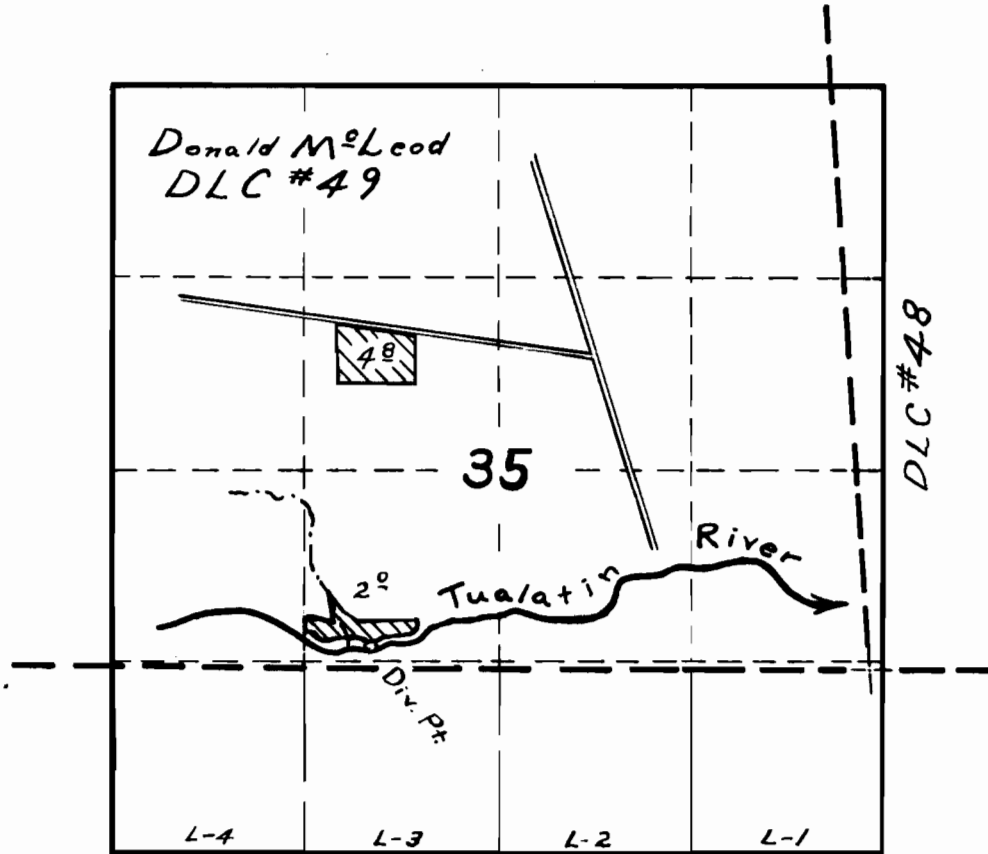

**FINAL PROOF SURVEY**

UNDER

Application No. 26813 Permit No. 21057

IN NAME OF

W.M. Wood

Surveyed 4-23 1956, by R.D.Best