


T. 5 E 6 S. R. 7 W. W. M.

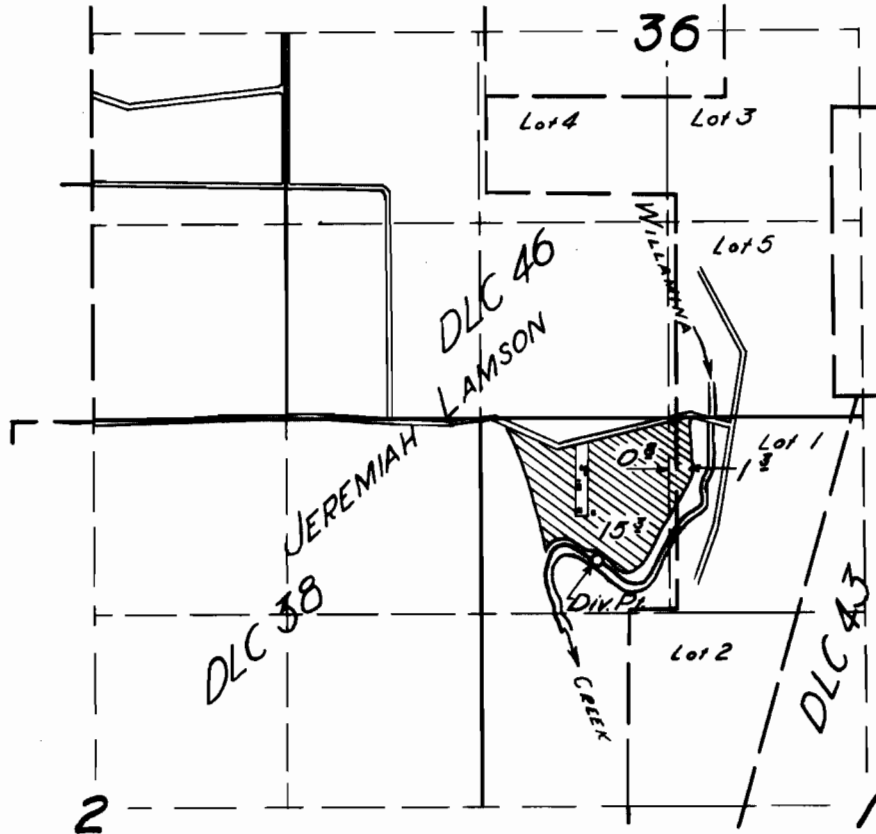

FINAL PROOF SURVEY
UNDER

Application No. 26834 Permit No. 21074
IN NAME OF

KEITH LAMSON

Surveyed 15 Mar 1956, by [Signature]