


T. 4 S. R. 4 W. W. M.

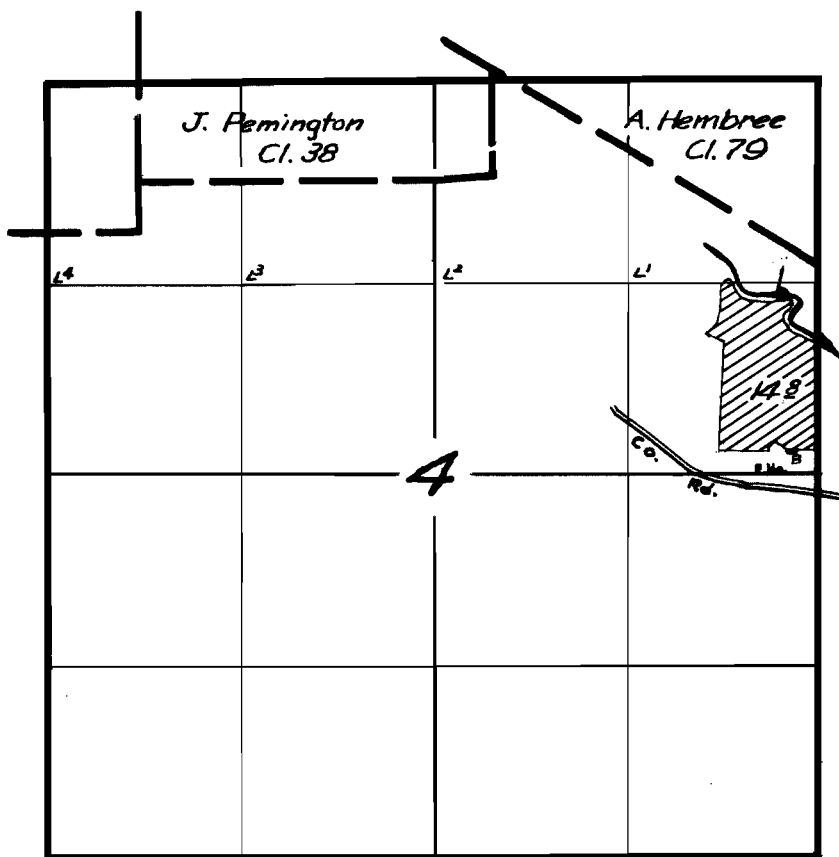

FINAL PROOF SURVEY
UNDER

Application No. 26865 Permit No. 21096
IN NAME OF

H.C. & Lucille McGhehey

Surveyed Mar 14 1956, by T. B. Bish