


TIS, R4W, WM

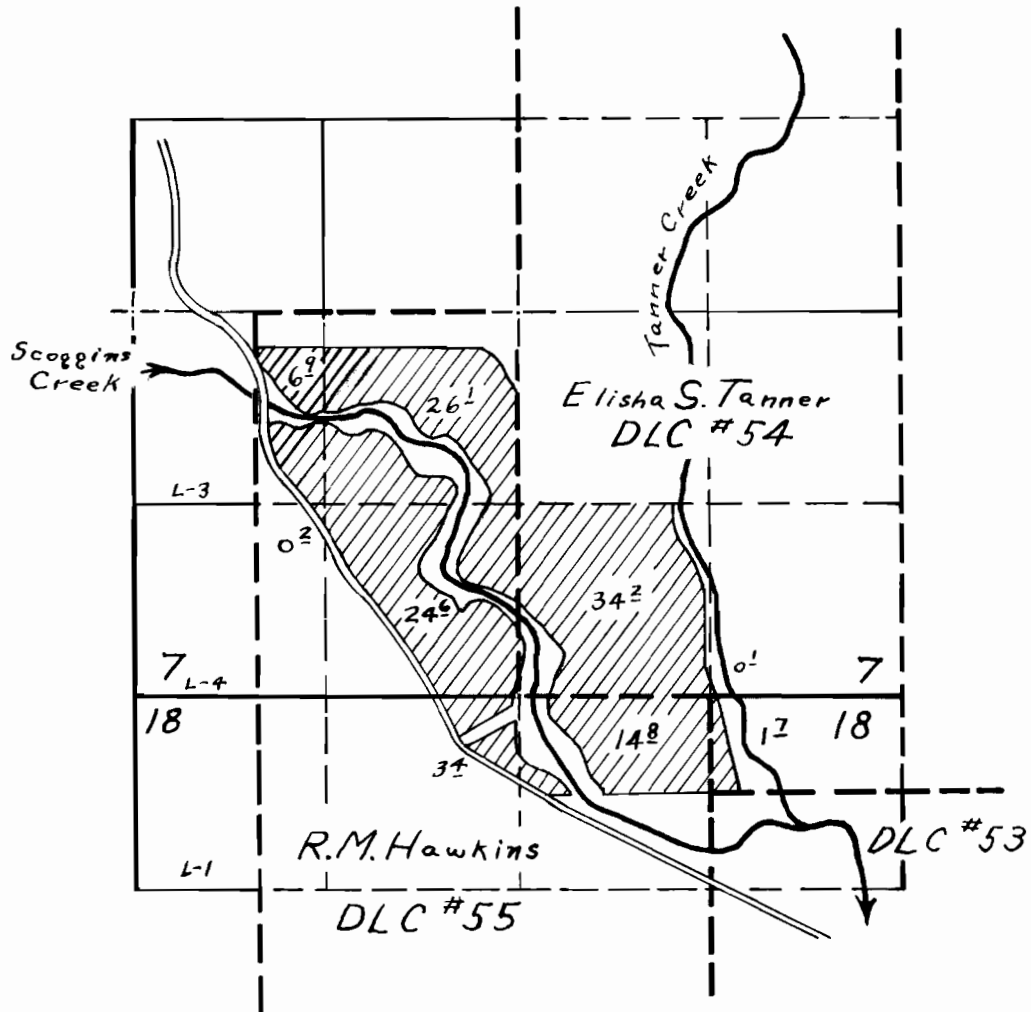

FINAL PROOF SURVEY

UNDER


Application No. 27061 Permit No. 21292

IN NAME OF

HIRAM H. SCOTT

Surveyed 4-24 1956, by R.D.BEST

RECEIVED
 APR 1952
 STATE ENGINEER
 SALEM, OREGON

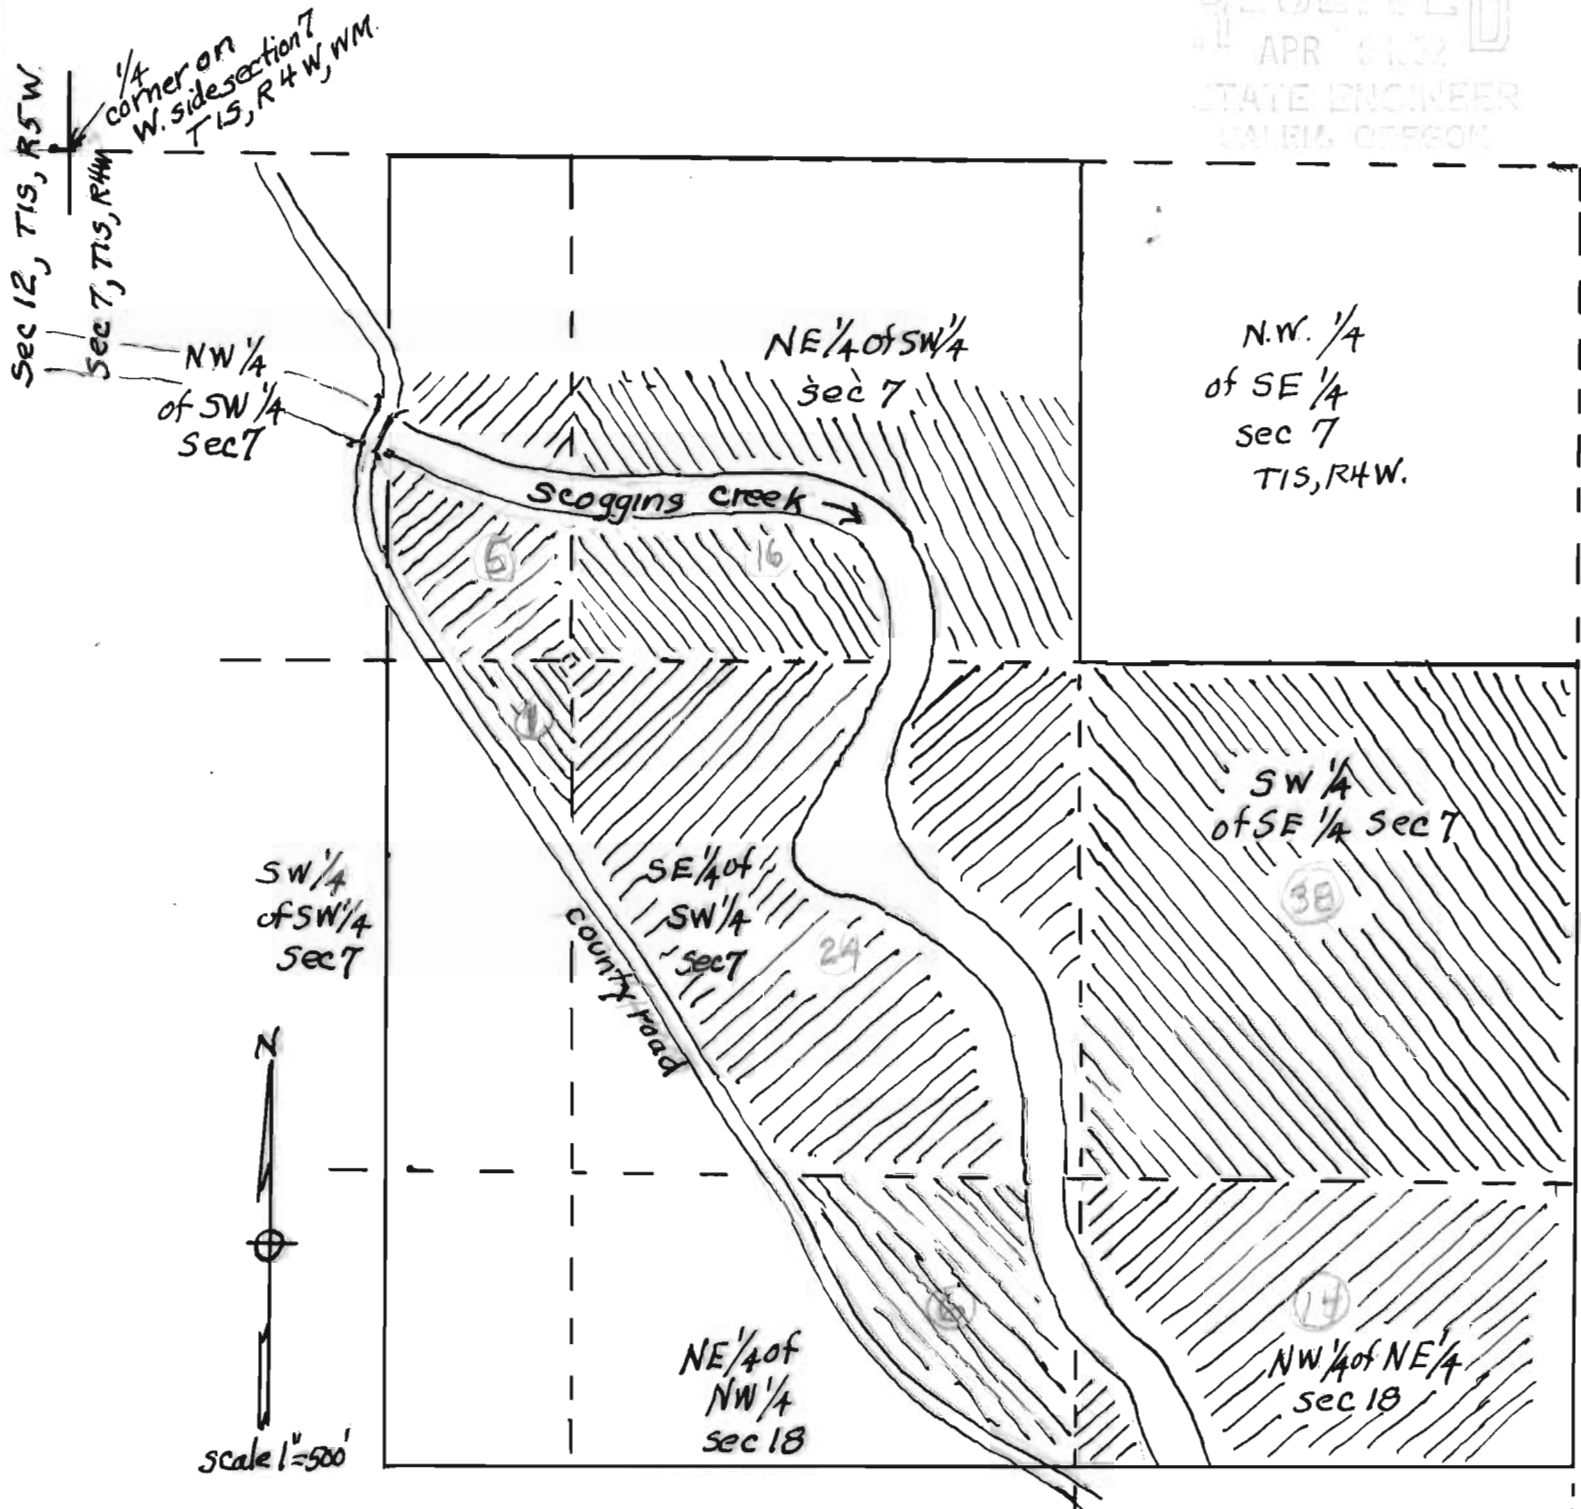

MAP TO accompany APPLICATION
 by Hiram H. Scott
 to divert water for irrigation purposes
 in sections 7 & 18, T1S, R4W, WM
 Washington County, Oregon
 4/7/52 H. F. Price, Surveyor

I certify that this map was made from notes
 of a survey made 4/5/52 for Hiram H. Scott and that the
 creek and road, are approximately as shown thereon.

Application No. 27061
 Permit No. 21292



27061